IREDELL COUNTY HEALTH DEPARTMENT

CI

STATESVILLE 704-878-5305 MOORESVILLE 704-664-5281

IMPROVEMENT PERMIT / AUTHORIZATION TO CONSTRUCT / OPERATION PERMIT / EXISTING SYSTEM INSPECTION

PERMIT# 108778 PIN# 3795-44-0555 DATE 9/19/02

OWNER OR CONTRACTOR Jerry Jenkins PHONE: Business (704) 872-0922 Home [redacted]

ADDRESS 732 Mossy Oak Lane, Statesville, N.C. 28625

LOCATION I-40 W, (R) 0.6 mile Rt, (L) New Sterling Church Rd past 2 story Brick House on Right

SUBDIVISION — BLOCK / SECTION — LOT — LOT AREA 40.39 Acres SITE CLASS PS DESIGN FLOW 360 L.T.A.R. .30 g.p.d./ft²

Septic Tank: 1000 Gallons; STB 1007 Date 10/08/02
Pump Tank: — Gallons; PT — Date —
Pump Make: — Model — Serial No. —
Nitrification Field: No Fields 1 Square Feet 1200 Linear Feet 480
No Lines 4@100' Trench Width 36" Max Trench Bottom Depth 32" Gravel Depth 12"

[X] New System [ ] Repair System Type: I, [II], III, IV, V, VI
System Description: Gravity, Conventional
Repair System Description: Gravity, Pump, Conventional
Maintenance Agreement Required: [ ] Yes [X] No

[X] House/Mod. Home No. Bedrooms 3
[ ] Mobile Home No. Bathrooms 2
[ ] Business No. Employees —
[ ] Other —


[ ] Slab [X] Crawl Space [ ] Basement w/plumbing [ ] Basement wo/plumbing

Water Supply: [X] Individual [ ] Public [ ] Community


Comments/Conditions: 1) Install dist. boxes w/speed levelers - four(4)

Comments/Conditions:
SEPTIC TANK INSTALLED USING POLY-LOK-FILTER + SEPTIC MARKER.

INITIAL SITE SKETCH

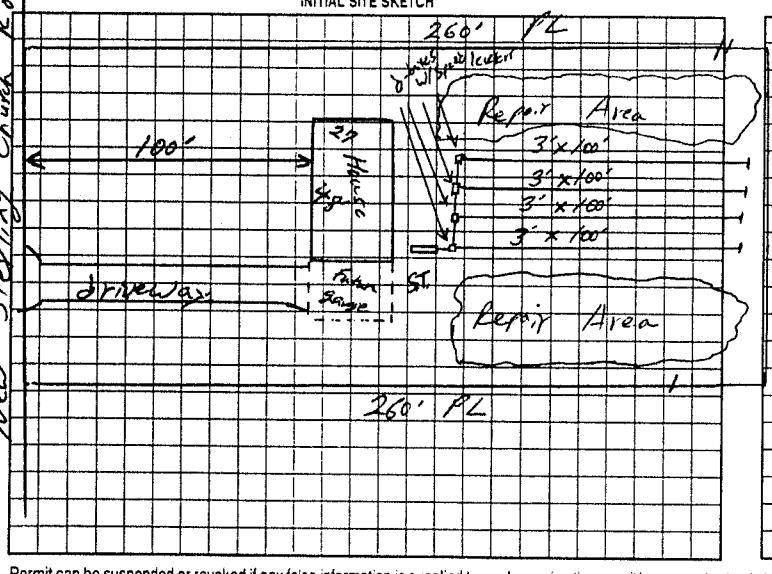

AS BUILT SKETCH

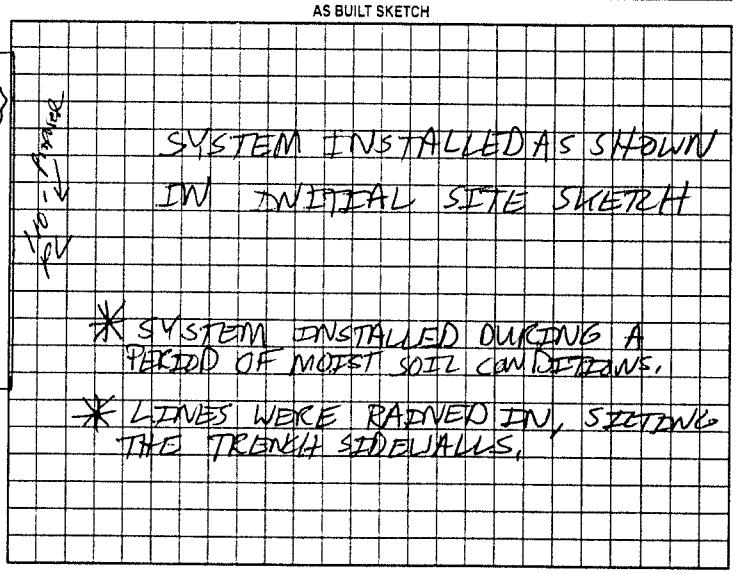

Permit can be suspended or revoked if any false information is supplied toward securing the permit/any unauthorized changes are made to the site any unauthorized changes are made in the installation of the system. Improvement Permit with plat valid without expiration. Improvement Permit with site plan valid for sixty months. Authorization to Construct is valid for a period equal to that of Improvement Permit – not to exceed sixty months

Signed: [signature] date 9/19/02 Installed by: TOMMY COTHREN

Improvement Permit by: [signature] date 9/19/02 Operation Permit by: [signature] date 12/11/02

Authorization to Construct by: [signature] date 9/19/02 Existing System Inspection by: — date —

HEALTH DEPT COPY WHITE OWNER COPY (FINAL) YELLOW OWNER COPY (INITIAL) PINK