IREDELL COUNTY HEALTH DEPARTMENT

STATESVILLE 704-878-5305 MOORESVILLE 704-664-5281

IMPROVEMENT PERMIT / AUTHORIZATION TO CONSTRUCT / OPERATION PERMIT / EXISTING SYSTEM INSPECTION

PERMIT# _____ PIN# _____ DATE 12-4-98

OWNER OR CONTRACTOR Kenneth Gray PHONE: Business _____ Home 873-7813

ADDRESS 2767 OMR

LOCATION I-40 W TR OMR before New Sterling Rd on Rt 2810 OMR

SUBDIVISION 000 BLOCK / SECTION _____ LOT _____ LOT AREA acreage SITE CLASS. _____ DESIGN FLOW _____ L.T.A.R. _____

Septic Tank: Ex. Gallons; STB 1012 Date 10-5-98

Pump Tank: _____ Gallons; PT _____ Date _____

Pump Make: _____ Model _____ Serial No. _____

Nitrification Field: No Fields 1 Square Feet 720 Linear Feet 240

No Lines 2 Trench Width 36" Max Trench Bottom Depth 36" Gravel Depth 12"

☐ New System ☑ Repair System Type: I, II, III, IV, V, VI

System Description: _____

Repair System Description: Conv. Gravity

Maintenance Agreement Required: ☐ Yes ☑ No

☑ House/Mod. Home No. Bedrooms 3

☐ Mobile Home No. Bathrooms ___

☐ Business No. Employees ___

☐ Other _____

☐ Slab ☑ Crawl Space ☐ Basement w/plumbing ☐ Basement wo/plumbing

Water Supply: ☑ Individual ☐ Public ☐ Community

Comments:/Conditions:

Check Tee In S.T.


Comments:/Conditions:

Replace Existing

INITIAL SITE SKETCH OMR



AS BUILT SKETCH

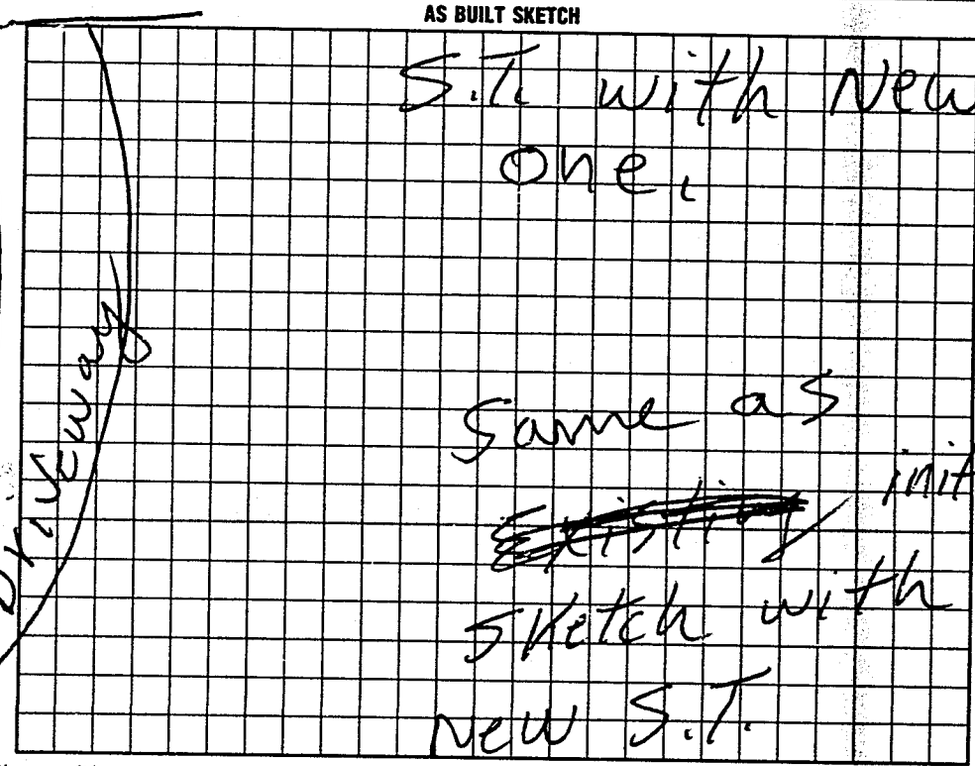

I understand that this permit can be suspended or revoked if any false information is supplied toward securing the permit/any unauthorized changes are made to the site/any unauthorized changes are made in the installation of the system. Improvement Permit with plat valid without expiration. Improvement Permit with site plan valid for sixty months. Authorization to Construct is valid for a period equal to that of Improvement Permit – not to exceed sixty months.

Signed: X Kenneth Gray date _____ Installed by: Escar Elliott

Improvement Permit by: E.C. Moore date 12-4-98 Operation Permit by: E. C. Moore date 12-14-98

Authorization to Construct by: E. C. Moore date 12-4-98 Existing System Inspection by: _____ date _____

HEALTH DEPT. COPY: WHITE INSPECTION COPY (FINAL): GREEN OWNER COPY (FINAL): YELLOW INSPECTION COPY (INITIAL): PINK OWNER COPY (INITIAL): GOLD