#059906

IREDELL COUNTY HEALTH DEPARTMENT

STATESVILLE 704-878-5305 MOORESVILLE 704-664-5281

IMPROVEMENT PERMIT / CERTIFICATE OF COMPLETION / OPERATION PERMIT / EXISTING SYSTEM INSPECTION

PROPERTY DESCRIPTION NO. 23327 DATE 4-2-96 TAX MAP NO 8V-A-13 Watershed Yes ✓ No

OWNER OR CONTRACTOR RONALD DISON PHONE Business Home 872-1148

ADDRESS 161 MIRACLE FARM ROAD STONY POINT, NC 28678

LOCATION I-40 W, TR OLD MOUNTAIN ROAD, TR MIRACLE FARM ROAD, ~0.15 MILE ON LEFT

SUBDIVISION BLOCK / SECTION LOT LOT AREA SITE CLASS PS DESIGN FLOW 360 LTAR EXISTING

Septic Tank: EXISTING Gallons: STB Date

Pump Tank: Gallons: PT Date

Pump Make: Model Serial No

Nitrification Field: No Fields Square Feet Linear Feet EXISTING

No Lines Trench Width Max Trench Bottom Depth Gravel Depth

New System Repair System Type CONV.

System Description CONV. GRAVITY

Repair System Description

Maintenance Agreement Required Yes No

Slab Crawl Space Basement w/plumbing Basement wo/plumbing

House/Mod Home No Bedrooms 3

Mobile Home No Bathrooms 2

Business No Employees


Other

Water Supply: Individual ✓ Community Public WELL


Comments:

Comments KEEP MH MINIMUM 5' FROM SYSTEM

INITIAL SITE SKETCH

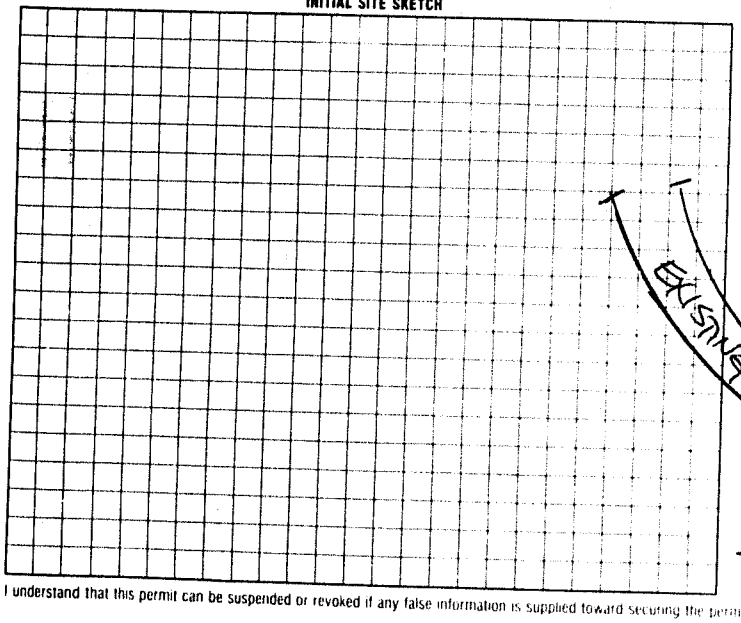

AS BUILT SKETCH

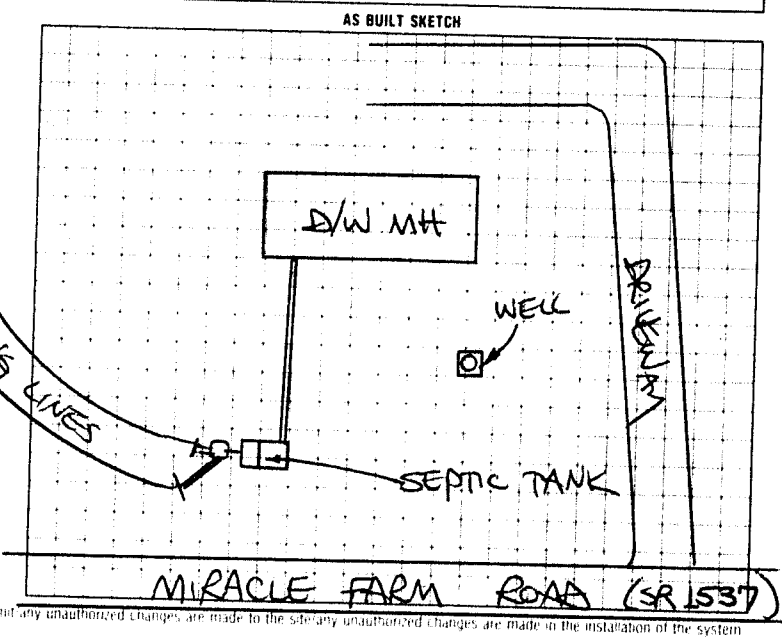

I understand that this permit can be suspended or revoked if any false information is supplied toward securing the permit any unauthorized changes are made to the site any unauthorized changes are made in the installation of the system

Signed

Improvement Permit by date

Existing System Inspection by STEVE HEDRICK date 4-2-96

Installed by

Certificate of Completion by date

Operation Permit by date

HEALTH DEPT COPY WHITE INSPECTION COPY (FINAL) GREEN OWNER COPY (FINAL) YELLOW INSPECTION COPY (INITIAL) PINK OWNER COPY (INITIAL) GOLD