GRAY HOUSE FARM 1905 (BED & BREAKFAST)

IREDELL COUNTY HEALTH DEPARTMENT

STATESVILLE 704-878-5305 MOORESVILLE 704-664-5281

IMPROVEMENT PERMIT / AUTHORIZATION TO CONSTRUCT / OPERATION PERMIT / EXISTING SYSTEM INSPECTION

PERMIT# _____ PIN# 3795 64 5287 DATE 5-7-98

OWNER OR CONTRACTOR PEGGY GRAY PHONE: Business _____ Home 873-6996

ADDRESS 2747 OLD MOUNTAIN ROAD STATESVILLE NC 28625

LOCATION I-40 WEST, TR OLD MOUNTAIN ROAD, 1~3.3 MILES ON LEFT AT BOX #2747

SUBDIVISION _____ BLOCK / SECTION _____ LOT _____ LOT AREA AMPLE SITE CLASS. PS DESIGN FLOW 480 L.T.A.R. EXISTING ~0.4 GPD/FT²

GREASE TRAP 1000 Gallons; STB 1017 Date 5-6-98

Pump Tank: _____ Gallons; PT _____ Date _____

Pump Make: _____ Model _____ Serial No. _____

Nitrification Field: No Fields ☐ Square Feet 600 Linear Feet 200

No Lines TWO Trench Width 36" Max Trench Bottom Depth 36" Gravel Depth 12"

☒ New System ☐ Repair System Type: I, (II), III, IV, V, VI

System Description: CONVENTIONAL GRAVITY

Repair System Description: CONV. GRAVITY

Maintenance Agreement Required: ☐ Yes ☒ No

☐ House/Mod. Home ☐ Mobile Home ☒ Business ☐ Other BED & BREAKFAST

No. Bedrooms 4 No. Bathrooms ___ No. Employees ___


☐ Slab ☒ Crawl Space ☐ Basement w/plumbing ☐ Basement wo/plumbing

Water Supply: ☒ Individual ☐ Public ☒ Community WELL

Comments:/Conditions: ① PLUMB ALL KITCHEN DRAINS INTO NEW GREASE TRAP INSTALLED AS SHOWN ② INSTALL NEW DIST. BOXES AS SHOWN ③ INSTALL NEW 3'x100' LINES AS FLAGGED ON SITE

Comments:/Conditions:

INITIAL SITE SKETCH ~SCALE: 1" = 40'

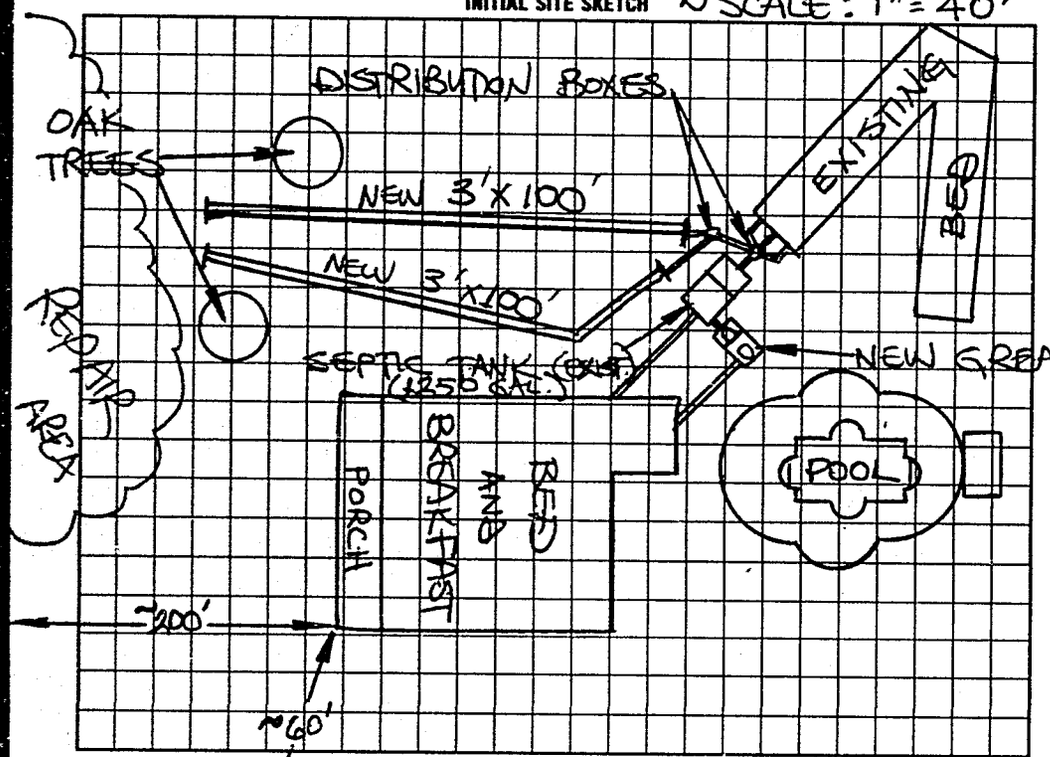

AS BUILT SKETCH

I understand that this permit can be suspended or revoked if any false information is supplied toward securing the permit/any unauthorized changes are made to the site/any unauthorized changes are made in the installation of the system. Improvement Permit with plat valid without expiration. Improvement Permit with site plan valid for sixty months. Authorization to Construct is valid for a period equal to that of Improvement Permit – not to exceed sixty months.

Signed: Peggy B. Gray date 5-7-98

Improvement Permit by: STEVE HEDRICK date 5-7-98

Authorization to Construct by: STEVE HEDRICK date 5-7-98

EXISTING WELL

Installed by: Johnny Rector / Gray

Operation Permit by: Mary C. O. & R.B. date 07-14-98

Existing System Inspection by: _____ date _____

HEALTH DEPT COPY: WHITE INSPECTION COPY (FINAL): GREEN OWNER COPY (FINAL): YELLOW INSPECTION COPY (INITIAL): PINK OWNER COPY (INITIAL): GOLD