IREDELL COUNTY HEALTH DEPARTMENT - *ENVIRONMENTAL HEALTH* ☐ STATESVILLE OFFICE 704-878-5305 ☐ MOORESVILLE OFFICE ~~704-664-5281~~

IMPROVEMENT PERMIT / AUTHORIZATION TO CONSTRUCT / OPERATION PERMIT / EXISTING SYSTEM INSPECTION

PERMIT # Relayout PIN # 3795-69-6756 DATE 7 June 2011

OWNER David Mash APPLICANT: PHONE: Home/Cell # (704) 585-2778 Business #

SITE ADDRESS 277 Miracle Farm Rd. OWNER / APPLICANT ADDRESS

SITE DIRECTIONS 64/90 - Turn into Hacking Farm Rd. TL Miracle Farm Rd. - on Rt.

SUBDIVISION BLOCK / SECTION LOT # LOT AREA 0.81 ac. DESIGN FLOW 360 gpd L.T.A.R. 0.3 x 577 gpd

Septic Tank 1000 Gallons: STB 160 Date 3-01-11 ☑ New System ☐ Repair ☐ Expansion System Type I II (III) IV V VI ☑ Residence No. Bedrooms 3 Water Supply

Pump Tank Gallons: P T Date System Description: 25% Reduction ☐ Business No. Persons ☐ Private

Pump Make Model Serial # Repair System Description: 25% Reduction ☐ Other No. Employees ☑ Public

No. Nitrification Fields: 1 No. Lines 4 Linear Feet 300 Maintenance Agreement Required ☐ YES ☑ NO ☐ Slab ☑ Crawl Space ☐ Community


Trench Width 36" Max. Trench Bottom Depth 36" Gravel Depth N/A ☑ GRAVITY ☐ PRESSURE ☐ Basement w/plumbing ☐ Basement w/o plumbing

Comments / Conditions: Property abandon old septic tank.

ST Has Marker

Polylock Fitting

INITIAL SITE SKETCH

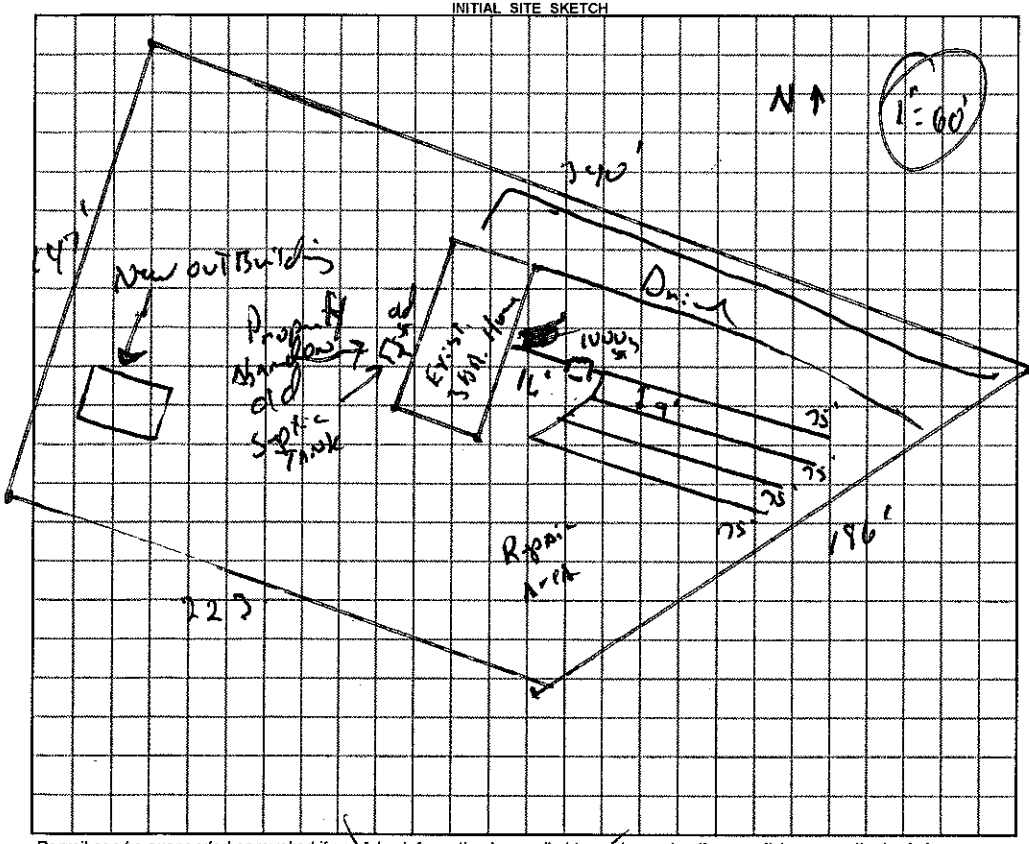

AS BUILT SKETCH

Installed as Drawn on initial site sketch.

Permit can be suspended or revoked if any false information is supplied toward securing the permit / any unauthorized changes are made to the site / any unauthorized changes are made in the installation of the system.

☐ *IMPROVEMENT PERMIT* with plat valid without expiration. ☑ *IMPROVEMENT PERMIT* with ~~plat valid without expiration~~ site plan valid 60 mo. ☑ *AUTHORIZATION TO CONSTRUCT* valid for period equal to IMPROVEMENT PERMIT--not to exceed 60 mo.

Owner / Applicant Signature: David Mash Date

IMPROVEMENT PERMIT by: REHS Date 7 June 11

AUTHORIZATION TO CONSTRUCT by: REHS Date 7 June 11

Installed by: KyM Grading

OPERATION PERMIT by: RS REHS Date 10 June 11

Existing System Inspected by: REHS Date

YOU SHOULD CONTACT A LOCATOR SERVICE PRIOR TO ANY EXCAVATION

White Copy – Environmental Health YELLOW COPY (Final) Owner / Applicant PINK COPY (Initial) Owner / Applicant