IREDELL COUNTY HEALTH DEPARTMENT

IMPROVEMENT PERMIT AND CERTIFICATE OF COMPLETION / OPERATIONS PERMIT

OWNER OR CONTRACTOR STEVE STAPLES DATE 4-8-92. PERMIT NO. _____

PHONE: Business _____ Home _____

LOCATION Old Mtn. Rd. north of Bradfords x Rds. - go 1.5 miles to T.L. into dev. Bear left at forks - go to 1st Stop Sign & T.R. - 2nd house on left. S.R. No. _____

SUBDIVISION NAME _____ LOT NO. _____ SECTION OR BLOCK NO. _____

House ☑ Mobile Home ☐ Business ☐ Other Repair.

No. Bedrooms _____ No. Bathrooms _____

Garbage Disposal Unit Yes ☐ No ☐

Auto. Dishwasher Yes ☐ No ☐

Auto. Wash. Machine Yes ☐ No ☐

Lot Area Ample.

Soil Characteristics _____


Application Rate _____

Topography Repair.

Depth to Water Table _____

Rock or other impervious formations _____

_____ Basement with Plumbing _____ Basement without Plumbing ✓ No Basement _____ Crawl Space

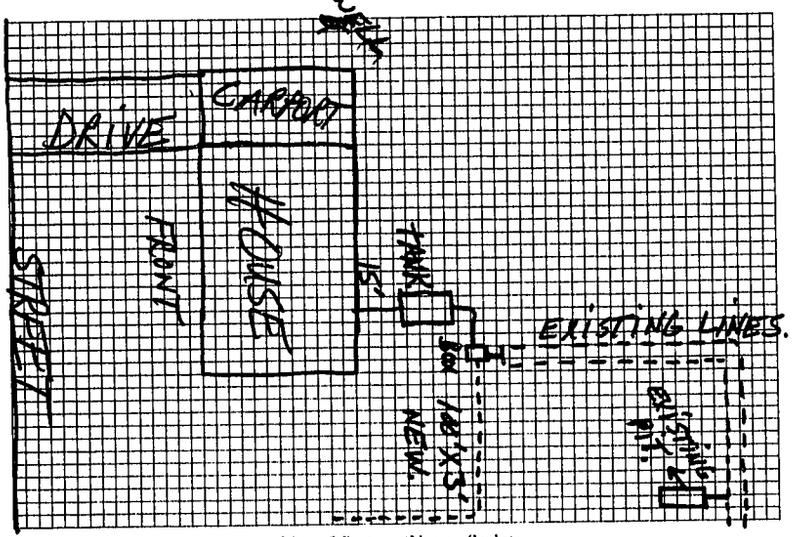

Plan of System (Not to Scale)

Size of Tank EXISTING. Gals.

Nitrification Field:

No. of Lines _____

Sq. Ft. 300 Linear Ft. 100

Depth of Stone in Lines 12"

Water Supply: Individual ☑ Public ☐

Installed by David & Andy Yount

I understand and agree to install a septic tank system as specified on this Improvement Permit.

Signed: _____

(IMPROVEMENT PERMIT IS VALID FOR 60 MONTHS FROM DATE OF ISSUE.)

IMPROVEMENT PERMIT BY Steve Brown

COMMENTS New tel installed & dist. box set. Tank pumped.

CERTIFICATE OF COMPLETION BY Steve Brown DATE 4-8-92.

EXISTING SYSTEM CHECKED BY _____ DATE _____

CONSTRUCTION MUST COMPLY WITH ALL OTHER APPLICABLE STATE AND LOCAL REGULATIONS

Permit is VOID if any unauthorized changes are made in installation of system, and/or if any unapproved changes are made to the site, and/or if any false information is supplied toward securing Improvement Permit.

Health Dept. Copy: White Inspection Dept. Copy: Yellow Sanitarian's Copy: Pink Owner's Copy: Gold