IREDELL COUNTY HEALTH DEPARTMENT

Statesville Office (704) 878-5305 Mooresville Office (704) 660-3625

IMPROVEMENT PERMIT / AUTHORIZATION TO CONSTRUCT / OPERATION PERMIT / EXISTING SYSTEM

PERMIT # 207360

APPLICANT: Property Masters PIN # 3755822903

SITE ADDRESS: 122 West Iredell Cir Statesville NC 28625 APPLICANT ADDRESS: 200 N Cobb Pkwy Marietta Ga 30062

SITE DIRECTIONS: I5 and Ford T/R Old Mtn Rd T/L West Iredell Cir Property on Right. PHONE: 704-787-2668 ALT. PHONE: N/A

SUBDIVISION: West Iredell Sites SECTION: N/A LOT # 125-128 LOT AREA: .470ac

Septic Tank Ex (gal) STB Date

Pump Tank (gal) PT Date

Pump Make Model Serial #

Nitrification Fields Ex # Lines Ex Linear Ft: Ex

Trench Width Ex Max. Trench Bottom Depth Ex Gravel Depth Ex

☐ New System ☐ Repair ☐ Expansion System Type: I / II / III IV V VI

System Description: Existing

Repair System Description:

Maintenance Agreement Required: ☐ YES ☒ NO

☒ GRAVITY ☐ PRESSURE

DESIGN FLOW: Ex L.T.A.R.: Ex

☒ Residence ☐ Business ☐ Other ☐ Slab ☐ Basement w/plumbing

No. Bedrooms Ex No. Persons Ex No. Employees ☒ Crawl Space

Water Supply: ☒ Private ☐ Public ☐ Community


☐ Basement w/o plumbing

Comments / Conditions: All building foundations must be 15' from any part of STS. All Step foundations must be 15' from any part of STS.

INITIAL SITE SKETCH

AS BUILT SKETCH

1" = 50'

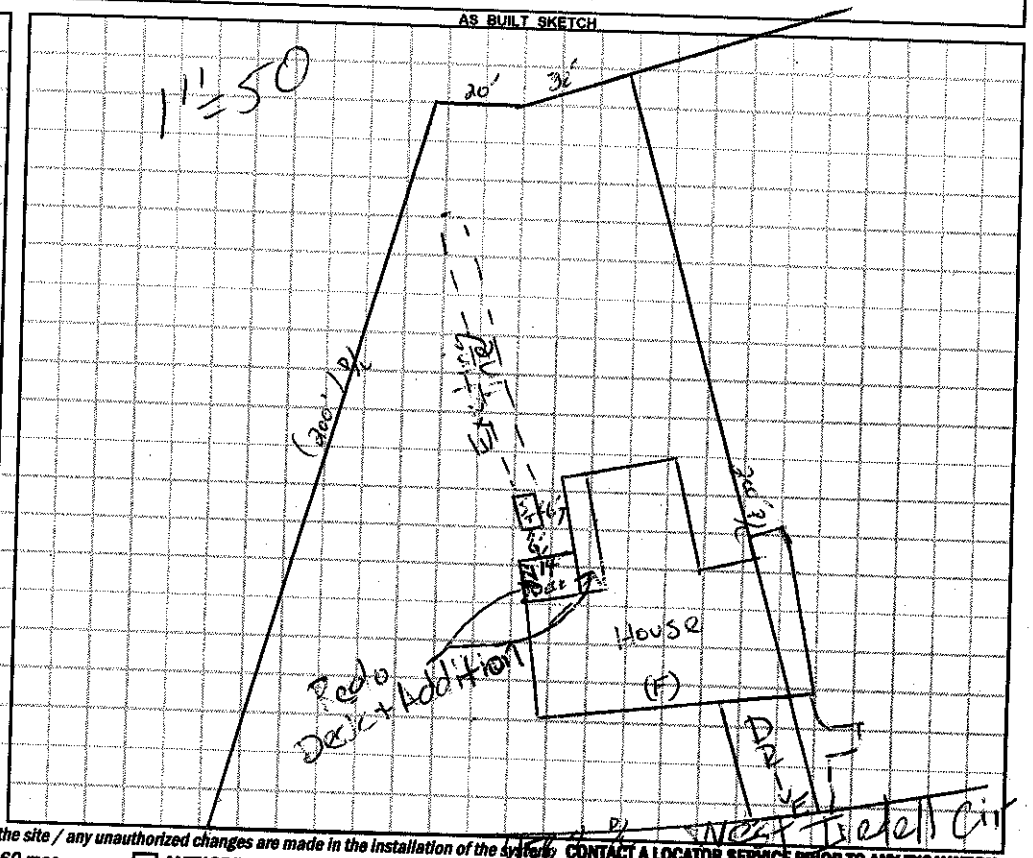

Permit can be suspended or revoked if any false information is supplied toward securing the permit / any unauthorized changes are made to the site / any unauthorized changes are made in the installation of the system.

☐ **IMPROVEMENT PERMIT** *with plat valid without expiration.* ☐ **IMPROVEMENT PERMIT** *with site plan valid for 60 mos.* ☐ **AUTHORIZATION TO CONSTRUCT** *valid for period equal to IMPROVEMENT PERMIT--not to exceed 60 mo.*

CONTACT A LOCATOR SERVICE PRIOR TO ANY EXCAVATION

Owner / Applicant Signature: Matt Clanet Date: Installed by:

IMPROVEMENT PERMIT by: Date: OPERATION PERMIT by: Date:

AUTHORIZATION TO CONSTRUCT by: Date: Existing System Inspected by: Date: 12/30/14

Health Dept. Copy - WHITE Applicant (Final Approval) - YELLOW Applicant (Conditional Approval) - PINK