IREDELL COUNTY HEALTH DEPARTMENT

STATESVILLE 704-878-5305 MOORESVILLE 704-664-5281

IMPROVEMENT PERMIT / CERTIFICATE OF COMPLETION / OPERATION PERMIT / EXISTING SYSTEM INSPECTION

PROPERTY DESCRIPTION NO. Repair DATE 7-23-93 TAX MAP NO. Repair

OWNER OR CONTRACTOR Jim Harding PHONE: Business _____ Home 873-8259

ADDRESS Rt. 8 Box 393 Statesville, N.C. 28677

LOCATION I40W TR Old Mt. Rd. Th West Iredell Circle, brace L at fork, Lot on corner on R.

SUBDIVISION West Iredell Circle BLOCK / SECTION _____ LOT _____ LOT AREA _____ SITE CLASS. Existing L.T.A.R. _____

Water Supply: ☐ Individual ☐ Community ☑ Public County Water

Septic Tank: Existing Gallons; STB — Date —

Pump Tank: — Gallons; PT — Date —

Nitrification Field: No Fields 2 Square Feet 375 Linear Feet 70'x5' bed

No Lines 1 Trench Width 5' Trench Depth >36" Gravel Depth 20"

☐ New System ☑ Repair System Type: I, II, IV, V, VI

System Description: Conventional, gravity

Repair System Description: Pump to conventional

Maintenance Agreement Required: ☐ Yes ☑ No

☑ House/Mod. Home No. Bedrooms 3

☐ Mobile Home No. Bathrooms 2

☐ Business No. Employees —

☐ Other _____

☐ Slab ☑ Crawl Space ☐ Basement w/plumbing ☐ Basement wo/plumbing

Garbage Disposal: ☐ Yes ☑ No

Auto. Dishwasher: ☐ Yes ☑ No


Auto. Washing Machine: ☑ Yes ☐ No

Other _____

Comments Only able to install 5'x70' bed instead of 5'x90', put in 20" of gravel instead of 18". Set new d-box.

INITIAL SITE SKETCH

AS BUILT SKETCH

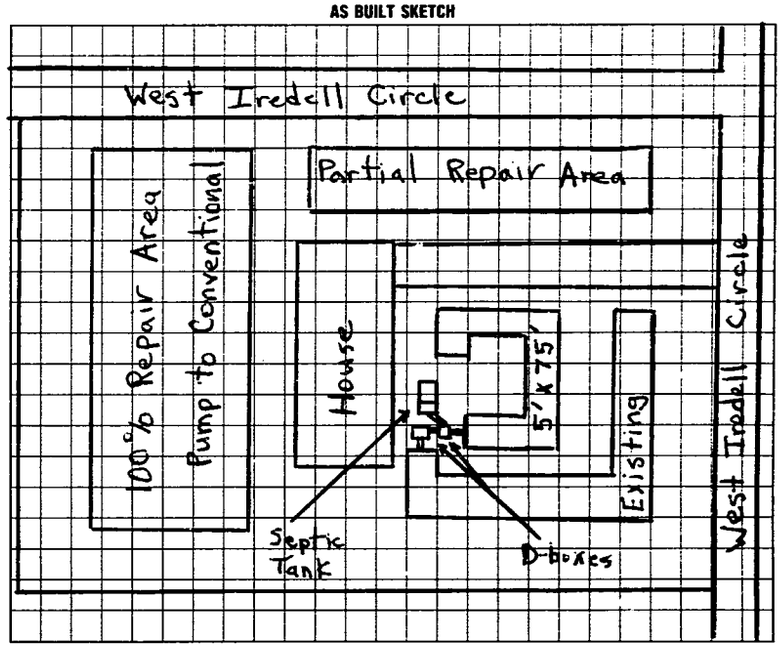

I understand that this permit can be suspended or revoked if any false information is supplied toward securing the permit/any unauthorized changes are made to the site/any unauthorized changes are made in the installation of the system. Improvement Permit is valid for 60 months from date of issuance.

Signed: _____ Installed by: James Hudler

Improvement Permit by: Steve Hedrick date 12-23-92 Certificate of Completion by: Michael J. Dennis date 7-23-93

Existing System Inspection by: _____ date _____ Operation Permit by: _____ date _____

HEALTH DEPT. COPY: WHITE INSPECTION COPY (FINAL): GREEN OWNER COPY (FINAL): YELLOW INSPECTION COPY (INITIAL): PINK OWNER COPY (INITIAL): GOLD

J