IREDELL COUNTY HEALTH DEPARTMENT

Statesville Office (704) 878-5305 Mooresville Office (704) 660-3625 PERMIT # 177608

IMPROVEMENT PERMIT / AUTHORIZATION TO CONSTRUCT / OPERATION PERMIT / EXISTING SYSTEM

PIN # 3795828185

APPLICANT: Tony Mitchell APPLICANT ADDRESS: 113 Molly Ln

SITE ADDRESS: 113 Molly Ln. PHONE: 704-928-6235 ALT. PHONE: N/A

SITE DIRECTIONS: Island Ford Rd. TR old Mtn Rd. TL Molly Ln.

SUBDIVISION: West Iredell Sites SECTION: N/A LOT # 65-68 LOT AREA: 0.43 acres DESIGN FLOW: 360 gpd L.T.A.R.: 0.3

Septic Tank Existing (gal) STB Date

Pump Tank (gal) PT Date

Pump Make Model Serial #

Nitrification Fields 1 # Lines 4 Linear Ft: 276

Trench Width 36" Max. Trench Bottom Depth 36" Gravel Depth N/A

☐ New System ☑ Repair ☐ Expansion System Type: I II (III) IV V VI

System Description:

Repair System Description: 25% Reduction

Maintenance Agreement Required: ☐ YES ☑ NO

☑ GRAVITY ☐ PRESSURE

☑ Residence No. Bedrooms 3

☐ Business No. Persons

☐ Other No. Employees

☐ Slab ☑ Crawl Space

☐ Basement w/plumbing ☐ Basement w/o plumbing

Water Supply


☐ Private

☑ Public

☐ Community

Comments / Conditions: Install a 25% Reduction system on contour with serial distribution. Replace septic tank if needed.

INITIAL SITE SKETCH

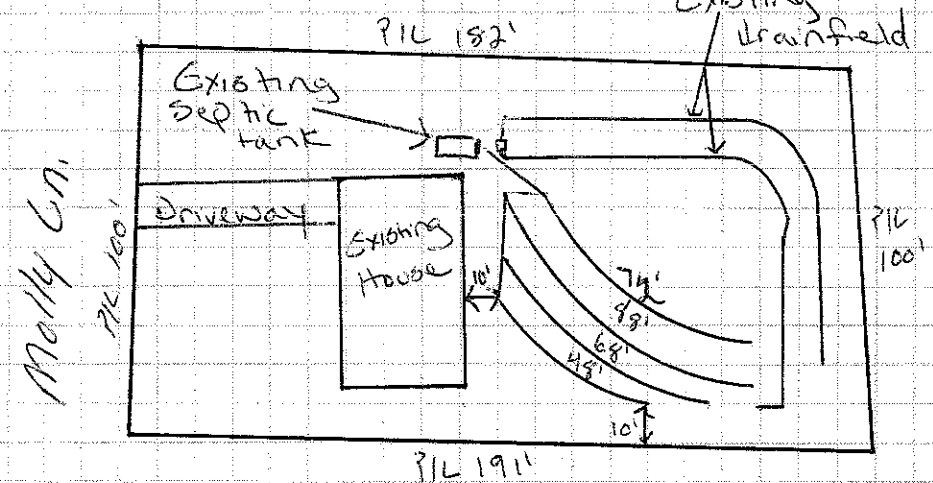

Scale ~1"=50'

AS BUILT SKETCH

- Quick 4 Chambers installed
- Installed as drawn

Permit can be suspended or revoked if any false information is supplied toward securing the permit / any unauthorized changes are made to the site / any unauthorized changes are made in the installation of the system. **CONTACT A LOCATOR SERVICE PRIOR TO ANY EXCAVATION**

☐ **IMPROVEMENT PERMIT** *with plat valid without expiration.* ☑ **IMPROVEMENT PERMIT** *with site plan valid for 60 mos.* ☑ **AUTHORIZATION TO CONSTRUCT** *valid for period equal to IMPROVEMENT PERMIT--not to exceed 60 mo.*

Owner / Applicant Signature: Tony Mitchell Date: 3-18-13 Installed by: K & M Grading

IMPROVEMENT PERMIT by: Justin Henderson Date: 3-14-13 OPERATION PERMIT by: Justin Henderson Date: 4-3-13

AUTHORIZATION TO CONSTRUCT by: Justin Henderson Date: 3-14-13 Existing System Inspected by: Date:

Health Dept. Copy - WHITE Applicant (Final Approval) - YELLOW Applicant (Conditional Approval) - PINK