IREDELL COUNTY HEALTH DEPARTMENT

STATESVILLE 704-878-5305 MOORESVILLE 704-664-5281

IMPROVEMENT PERMIT / AUTHORIZATION TO CONSTRUCT / OPERATION PERMIT / EXISTING SYSTEM INSPECTION

PERMIT# 089932 PIN# 4705050441 PT DATE 7-25-00

OWNER OR CONTRACTOR Earlie Hager PHONE: Business _____ Home 876 3154

ADDRESS 524 Cove Gap RD Statesville

LOCATION 40W TR OMR TR Massey Rd/ TR Waugh Lot on (L) Before Cul de sac

SUBDIVISION Ben Estates BLOCK / SECTION _____ LOT 1 LOT AREA 0.45 SITE CLASS _____ DESIGN FLOW _____ L.T.A.R. _____

Septic Tank: 1000 Ex Gallons: STB _____ Date _____

Pump Tank: _____ Gallons: PT _____ Date _____

Pump Make: _____ Model _____ Serial No. _____

Nitrification Field: No Fields ____ Square Feet _____ Linear Feet _____

No Lines _____ Trench Width _____ Max Trench Bottom Depth _____ Gravel Depth _____

☐ New System ☐ Repair System Type: I. II. III. IV. V. VI

System Description: _____

Repair System Description: _____

Maintenance Agreement Required: ☐ Yes ☐ No

☐ House/Mod. Home No. Bedrooms 2

☒ Mobile Home No. Bathrooms 1

☐ Business No. Employees ____

☐ Other _____

☐ Slab ☒ Crawl Space ☐ Basement w/plumbing ☐ Basement wo/plumbing


Water Supply: ☒ Individual ☐ Public ☐ Community

Comments:/Conditions:

Comments:/Conditions: Existing System check
Recommend pumping Tank

INITIAL SITE SKETCH

Not to Scale AS BUILT SKETCH

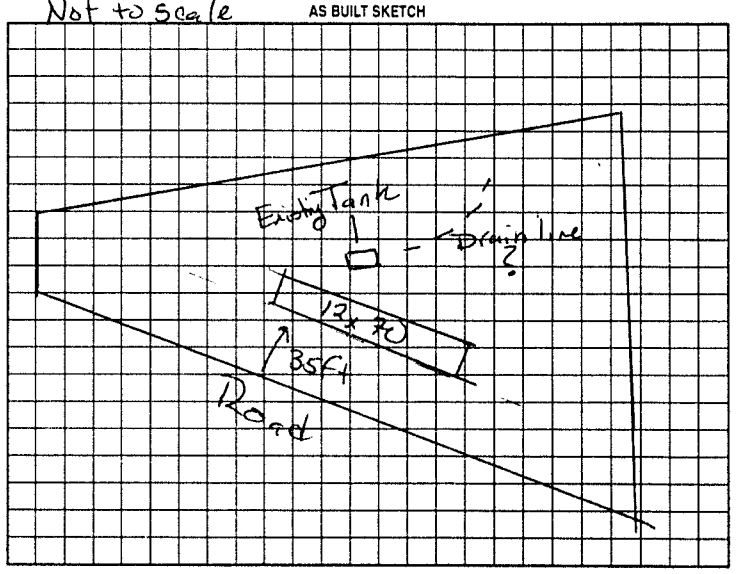

Permit can be suspended or revoked if any false information is supplied toward securing the permit/any unauthorized changes are made to the site/any unauthorized changes are made in the installation of the system. Improvement Permit with plat valid without expiration. Improvement Permit with site plan valid for sixty months. Authorization to Construct is valid for a period equal to that of Improvement Permit – not to exceed sixty months.

Signed: _____ date _____

Improvement Permit by: _____ date _____

Authorization to Construct by: _____ date _____

Installed by: _____

Operation Permit by: _____ date _____

Existing System Inspection by: Mary C Ostby RS date 7-25-00

HEALTH DEPT. COPY. WHITE OWNER COPY (FINAL). YELLOW OWNER COPY (INITIAL). PINK