IREDELL COUNTY HEALTH DEPARTMENT

STATESVILLE 704-878-5305 MOORESVILLE 704-664-5281

IMPROVEMENT PERMIT / AUTHORIZATION TO CONSTRUCT / OPERATION PERMIT / EXISTING SYSTEM INSPECTION

PERMIT# 1472666 PIN# 3796008124 DATE 1/8/08

OWNER OR APPLICANT Clyde Hall Enterprises Inc. PHONE: Business 704.534.2490 Home 704.664.6400

ADDRESS P.O. Box 3397 Mooresville, NC 28117

LOCATION 122 Burning Lane Stony Point, NC 28678

SUBDIVISION Caine Road Estate BLOCK / SECTION IV LOT 36 LOT AREA 0.594 Acres SITE CLASS. P.S. DESIGN FLOW 360 gal/day L.T.A.R. 0.3

Septic Tank: 1000 Gallons: STB 1007 Date 6-8-09

Pump Tank: ____ Gallons: PT ____ Date ____

Pump Make: ____ Model ____ Serial No. ____

Nitrification Field: No Fields 1 Square Feet 1200 Linear Feet ~~300~~

No Lines 3 Trench Width 36" Max Trench Bottom Depth 36" Gravel Depth ____

☑ New System ☐ Repair ☐ Expansion System Type: I II III IV V VI

System Description: 25% Reduction

Repair System Description: 25% Pump Reduction

Maintenance Agreement Required: ☐ Yes ☑ No

☑ House/Mod. Home No. Bedrooms 3

☐ Mobile Home No. Persons ____

☐ Business No. Employees ____

☐ Other ____


Water Supply: ☐ Individual ☑ Public ☐ Community

☑ Gravity ☐ Pressure ☐ Slab ☑ Crawl Space ☐ Basement w/plumbing ☐ Basement wo/plumbing


Comments/Conditions: - maintain all setbacks
- install on contour

Comments/Conditions: BOWCO Filter - MARKED
SYSTEM 10'+ OFF MARKED P/L

INITIAL SITE SKETCH

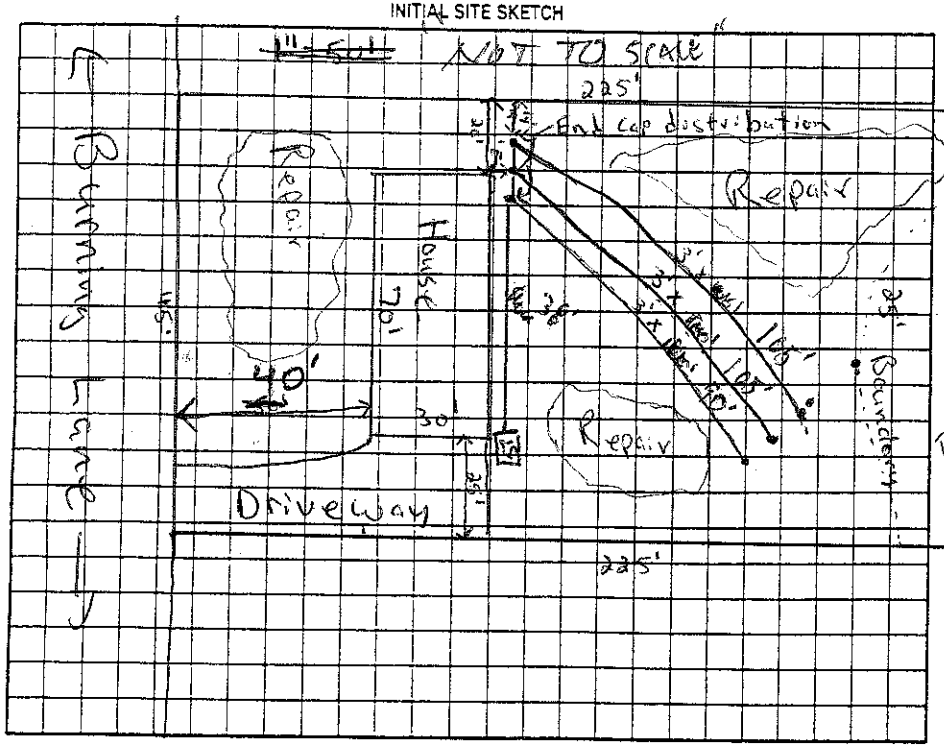

AS BUILT SKETCH

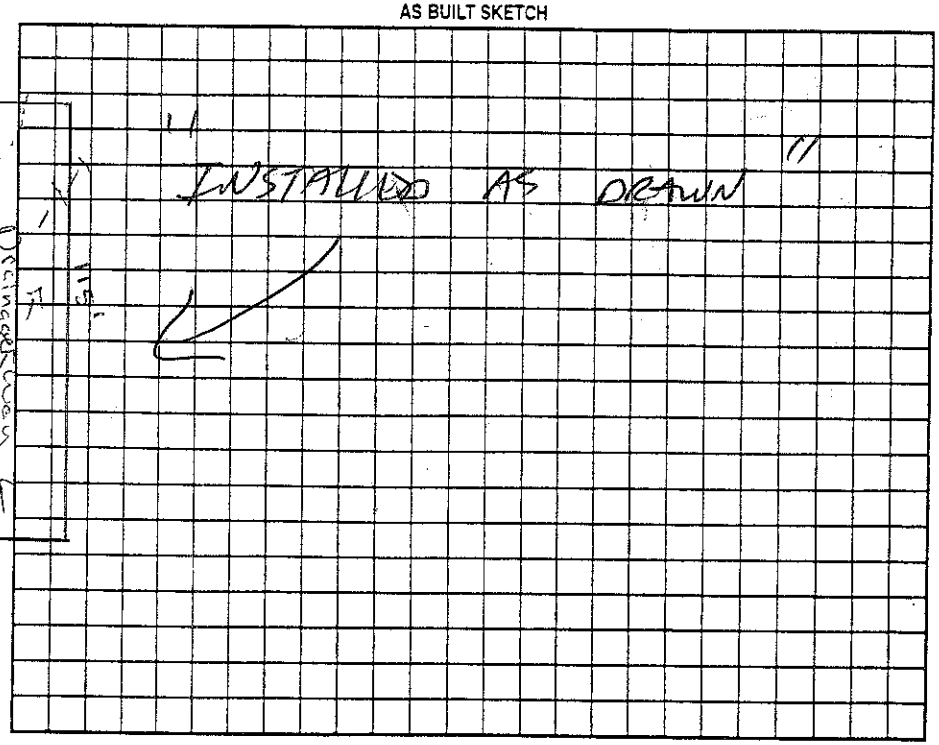

Permit can be suspended or revoked if any false information is supplied toward securing the permit/any unauthorized changes are made to the site/any unauthorized changes are made in the installation of the system. Improvement Permit with plat valid without expiration ☐ Improvement Permit with site plan valid for sixty months ☑ Authorization to Construct is valid for a period equal to that of Improvement Permit – not to exceed sixty months.

Signed: [redacted] date 5-20-09

Improvement Permit by: Rachel Mc Swain date 1/8/08

Authorization to Construct by: [signature] R.S. date 20 May 09

Installed by: COTHERN & SONS Grading 1838

Operation Permit by: [signature] date 7-15-09

Existing System Inspection by: ____ date ____

HEALTH DEPT. COPY: WHITE OWNER COPY (FINAL): YELLOW OWNER COPY (INITIAL): PINK