IREDELL COUNTY HEALTH DEPARTMENT

STATESVILLE 704-878-5305 (I) MOORESVILLE 704-664-5281

IMPROVEMENT PERMIT / AUTHORIZATION TO CONSTRUCT / OPERATION PERMIT / EXISTING SYSTEM INSPECTION

PERMIT# 84162 PIN# 3795 09 0951

OWNER OR CONTRACTOR Clyde Hall Enterprizes PHONE: Business 664 6400 Home DATE 10-15-99

ADDRESS PO Box 1556 Mooresville, N.C.

LOCATION Old Mtn Rd TL Cain Rd on left

SUBDIVISION Cain Rd Est. BLOCK / SECTION 1 LOT 7 LOT AREA .15 acres SITE CLASS PS DESIGN FLOW 360 L.T.A.R. .27

Septic Tank: 1000 Gallons; STB 1012 Date 6-29-99

Pump Tank: Gallons; PT Date

Pump Make: Model Serial No.

Nitrification Field: No Fields 1 Square Feet 1008 Linear Feet 336

No Lines 5 Trench Width 36" Max Trench Bottom Depth 36" Gravel Depth N/A

☑ New System ☐ Repair System Type: I, II, III, IV, V, VI

System Description: Gravity 25% Reduction

Repair System Description: Pump To LPP Panels

Maintenance Agreement Required: ☐ Yes ☑ No

☐ House/Mod. Home ☑ Mobile Home ☐ Business ☐ Other

No. Bedrooms 3 No. Bathrooms 2 No. Employees


☐ Slab ☐ Crawl Space ☐ Basement w/plumbing ☐ Basement wo/plumbing

Water Supply: ☐ Individual ☑ Public ☐ Community


Comments:/Conditions:

Comments:/Conditions: Turbidite filter Installed
S.T. marker Installed
- Installed EZ Lay System

INITIAL SITE SKETCH 208'

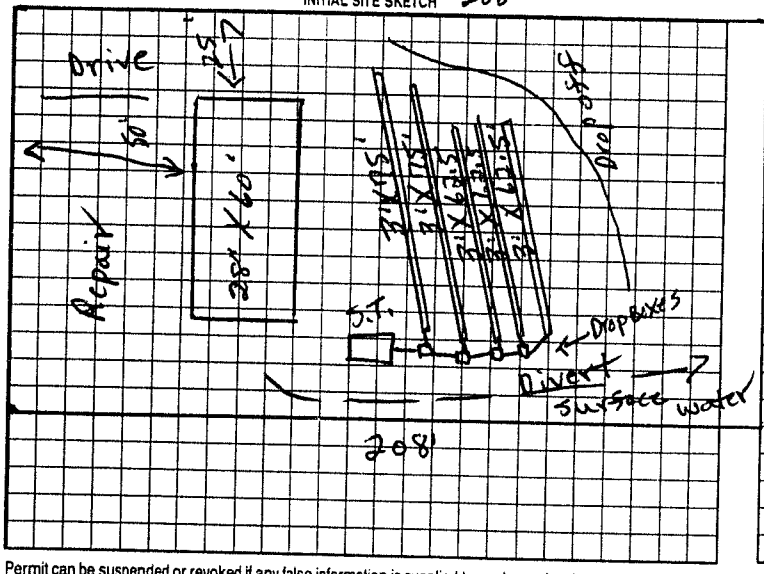

AS BUILT SKETCH

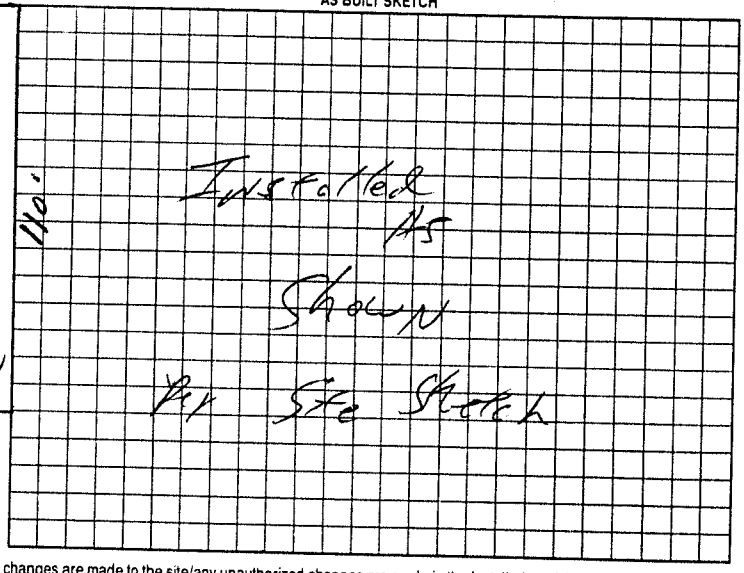

Permit can be suspended or revoked if any false information is supplied toward securing the permit/any unauthorized changes are made to the site/any unauthorized changes are made in the installation of the system. Improvement Permit with plat valid without expiration. Improvement Permit with site plan valid for sixty months. Authorization to Construct is valid for a period equal to that of Improvement Permit – not to exceed sixty months.

Signed: ~~X~~ Barbara Southern date 2/4/00 Installed by: A-1 Backhoe

Improvement Permit by: P.C. Moore date 10-15-99 Operation Permit by: William G. Johnson date 12-12-02

Authorization to Construct by: P.C. Moore date 10-15-99 Existing System Inspection by: date

HEALTH DEPT. COPY: WHITE OWNER COPY (FINAL): YELLOW OWNER COPY (INITIAL): PINK

Cain Rd