IREDELL COUNTY HEALTH DEPARTMENT

STATESVILLE 704-878-5305 MOORESVILLE 704-664-5281

IMPROVEMENT PERMIT / AUTHORIZATION TO CONSTRUCT / OPERATION PERMIT / EXISTING SYSTEM INSPECTION

PERMIT # 156731 PIN # 3796-00-2122 DATE 9 June 09

OWNER or APPLICANT Clyde Hall Enterprises, Inc PHONE: Business (704) 746-4492 Home:

OWNER or APPLICANT ADDRESS PO Box 3397 Mooresville, N.C.

LOCATION / DIRECTIONS Old NW Rd. Turn onto Cain Rd. TL Grain Rd. TR Burns Land.

SUBDIVISION Cain Rd. Estates BLOCK / SECTION LOT # 35 LOT AREA DESIGN FLOW 360 g.p.d. L.T.A.R. 0.3 g/ft²/d

Septic Tank 1000 Gallons: STB 1000 Date 8-11-09

Pump Tank Gallons: P T Date

Pump Make Model Serial #

Nitrification Field No Fields 1 No Lines 4 Linear Feet 300

Trench Width 36" Max. Trench Bottom Depth 36" Gravel Depth NA

☑ New System ☐ Repair ☐ Expansion System Type I II (III) IV V VI

System Description: 25% Reduction

Repair System Description: 50% Reduction - LPP

Maintenance Agreement Required ☐ YES ☑ NO

☑ GRAVITY ☐ PRESSURE

☑ Residence No. Bedrooms 3 ☐ Business No. Persons ☐ Other No. Employees ☐ Slab ☑ Crawl Space ☐ Basement w/plumbing ☐ Basement w/o plumbing

Water Supply: ☐ Private ☑ Public ☐ Community

Comments / Conditions

Follow contour / Divert surface water run-off away from system area. Honor setbacks.

Comments / Conditions

Poly Tec Installed / SI has warranty

INITIAL SITE SKETCH

Please see Attached site sketch

AS BUILT SKETCH

Installed as Drawn on Attached site sketch.

Permit can be suspended or revoked if any false information is supplied toward securing the permit / any unauthorized changes are made to the site / any unauthorized changes are made in the installation of the system.

☐ *IMPROVEMENT PERMIT w / plat valid without expiration* ☑ *IMPROVEMENT PERMIT w / site plan valid for 60 mos.* ☐ *AUTHORIZATION TO CONSTRUCT valid for period equal to IMPROVEMENT PERMIT-not to exceed 60 mo.*

Owner / Applicant Signature: Date 7/6/09

Improvement Permit by: , R.S. Date 9 June 09

Authorization to Construct by: Date 8-11-09

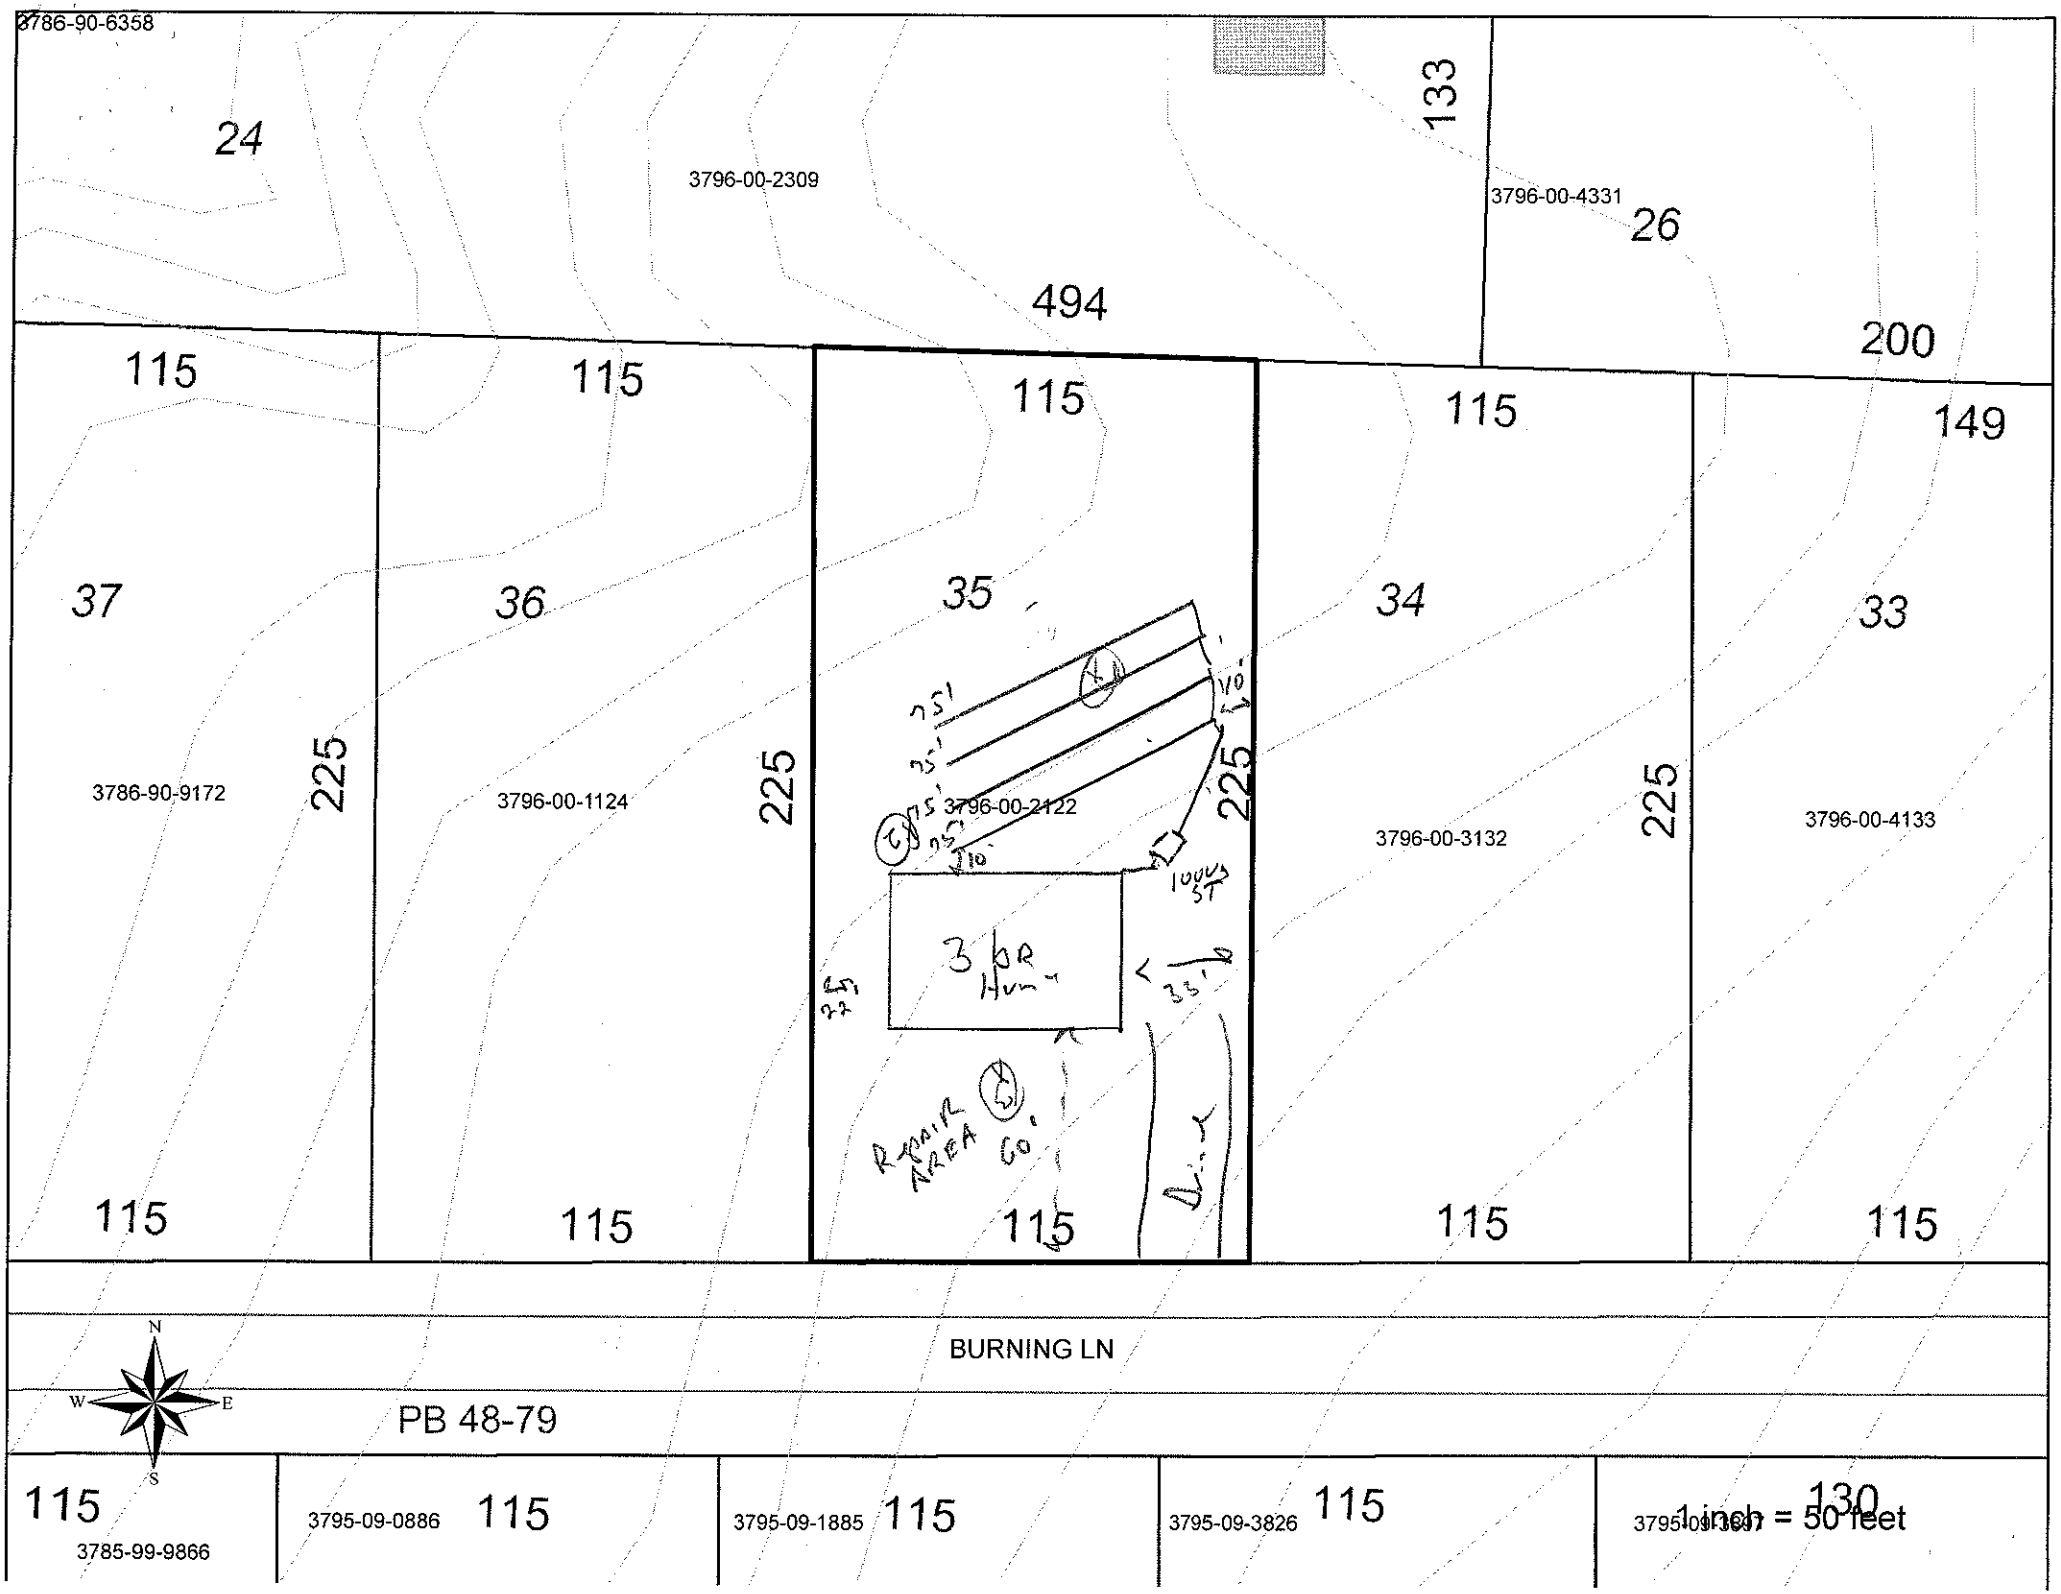
Installed by: Tommy Cothern

Operation Permit by: , R.S. Date: 30 September 09

Existing System Inspected by: Date:

YOU SHOULD CONTACT A LOCATOR SERVICE PRIOR TO ANY EXCAVATION.

WHITE COPY Environmental Health YELLOW COPY (Final) Owner / Applicant PINK COPY (Initial) Owner / Applicant


3786-90-6358
24
3796-00-2309
133
3796-00-4331
26
494
200
115
115
115
115
149
37
36
35
34
33
3786-90-9172
225
3796-00-1124
225
3796-00-2122
225
3796-00-3132
225
3796-00-4133
3 bR
115
115
115
115
115
BURNING LN
PB 48-79
N
W
E
S
115
3785-99-9866
3795-09-0886
115
3795-09-1885
115
3795-09-3826
115
130
1 inch = 50 feet