Replaces Permit Issued 31 August 09

IREDELL COUNTY HEALTH DEPARTMENT - *ENVIRONMENTAL HEALTH* ☒ STATESVILLE OFFICE 704-878-5305 ☐ MOORESVILLE OFFICE 704-664-5281

IMPROVEMENT PERMIT / AUTHORIZATION TO CONSTRUCT / OPERATION PERMIT / EXISTING SYSTEM INSPECTION

PERMIT # 158022 PIN # 3796-00-3132 DATE 11 October 11

OWNER Clyde Hall Enterprises APPLICANT: Frank Bailey PHONE: Home/Cell # (704) 746-4492 Business #

SITE ADDRESS 110 Burning Land Stat. OWNER / APPLICANT ADDRESS

SITE DIRECTIONS I40W TR old mtn. Rd. TL Conrad TL Conrad TR Burning Ln. 2nd Lot on Rt.

SUBDIVISION Cain Road Est. BLOCK / SECTION LOT # 34 LOT AREA 0.6Ac. DESIGN FLOW 360 gpd L.T.A.R. 0.3 gpd/~~ft~~²d.

Septic Tank 1000 Gallons: STB 160 Date 9-10-11 ☑ New System ☐ Repair ☐ Expansion System Type I II III IV V VI

Pump Tank Gallons: PT Date System Description: 25% Reduction System.

Pump Make Model Serial # Repair System Description: 50% Reduction System.

No. Nitrification Fields: 1 No. Lines 3 Linear Feet 300 Maintenance Agreement Required ☐ YES ☒ NO

Trench Width 36" Max. Trench Bottom Depth 36" Gravel Depth N/A ☑ GRAVITY ☐ PRESSURE

☑ Residence ☐ Business ☐ Other ☐ Slab ☐ Basement w/plumbing — No. Bedrooms 3 — No. Persons — No. Employees — ☑ Crawl Space — ☐ Basement w/o plumbing


Water Supply: ☐ Private ☑ Public ☐ Community

Comments / Conditions


ST has marker

Pulp/lock Filter

INITIAL SITE SKETCH

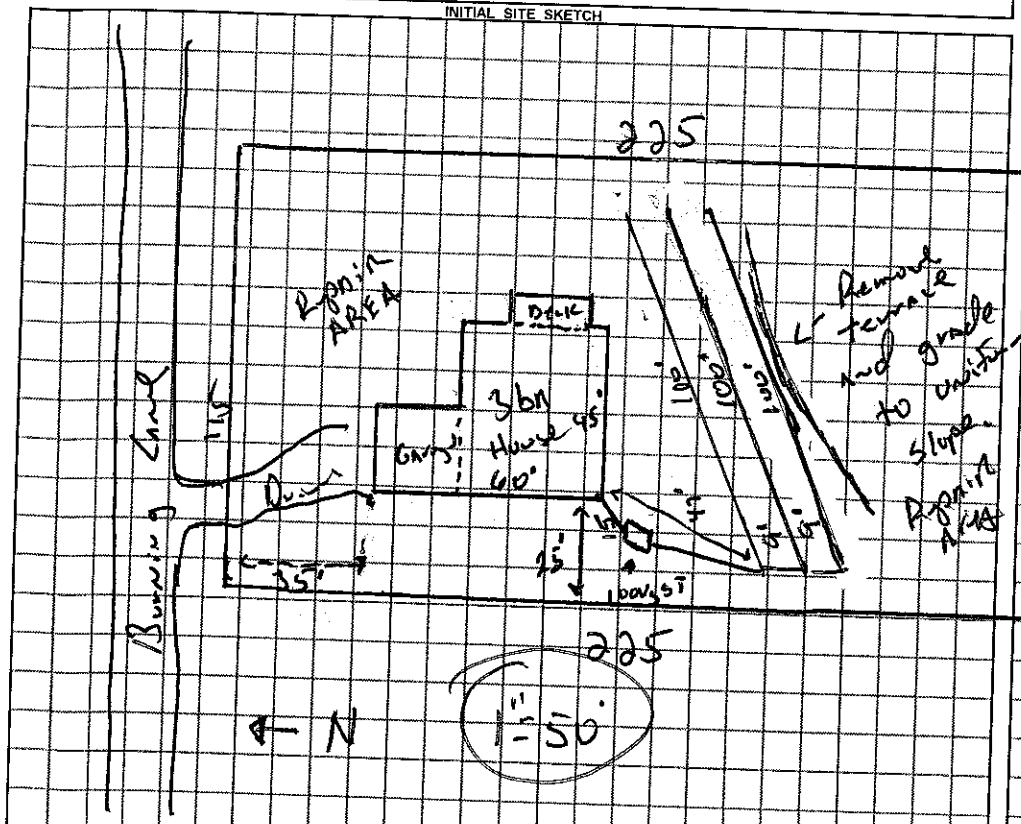

AS BUILT SKETCH

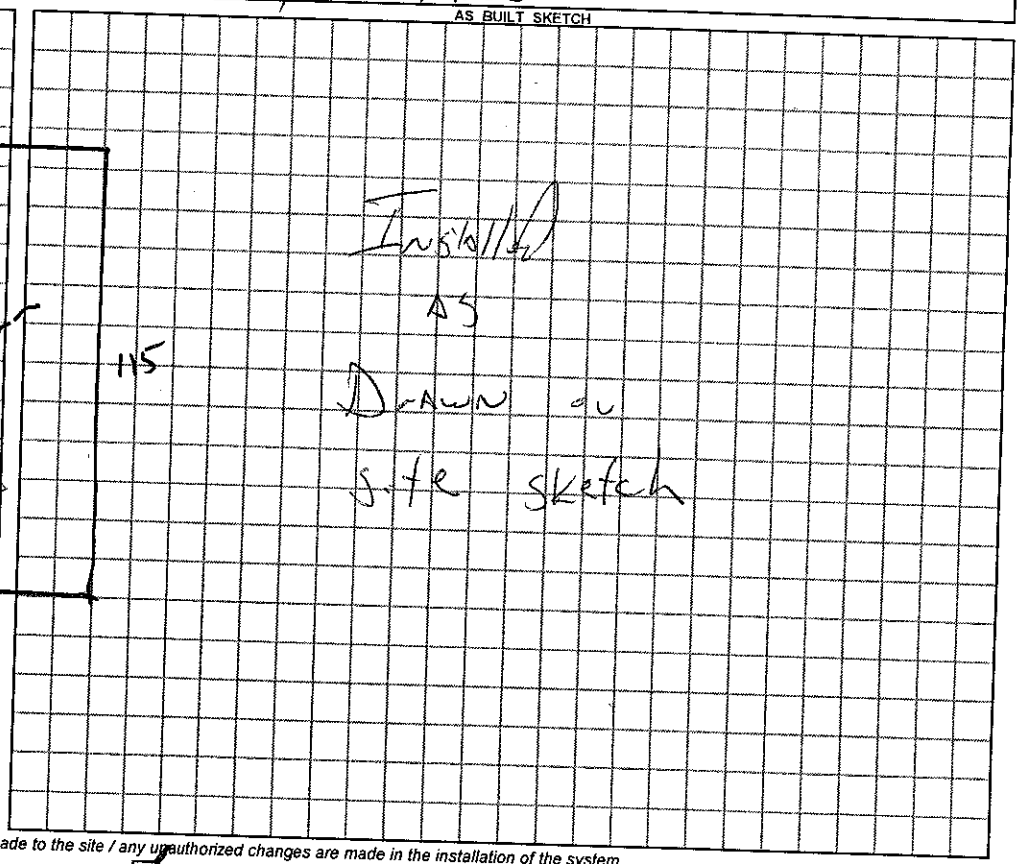

Permit can be suspended or revoked if any false information is supplied toward securing the permit / any unauthorized changes are made to the site / any unauthorized changes are made in the installation of the system.

☐ *IMPROVEMENT PERMIT* with plat valid without expiration. ☑ *IMPROVEMENT PERMIT* with ~~plat~~ site plan valid 60 mo. ☑ *AUTHORIZATION TO CONSTRUCT* valid for period equal to IMPROVEMENT PERMIT--not to exceed 60 mo.

Owner / Applicant Signature: Date 10-11-11 Installed by: Tommy Cothren

IMPROVEMENT PERMIT by: REHS Date 11 Oct. 11 OPERATION PERMIT by: REHS Date 12/12/11

AUTHORIZATION TO CONSTRUCT by: REHS Date 11 Oct. 11 Existing System Inspected by: REHS Date

YOU SHOULD CONTACT A LOCATOR SERVICE PRIOR TO ANY EXCAVATION

White Copy – Environmental Health YELLOW COPY (Final) Owner / Applicant PINK COPY (Initial) Owner / Applicant