IREDELL COUNTY HEALTH DEPARTMENT

STATESVILLE 704-878-5305 MOORESVILLE 704-664-5281

IMPROVEMENT PERMIT / AUTHORIZATION TO CONSTRUCT / OPERATION PERMIT / EXISTING SYSTEM INSPECTION

PERMIT# 81604 PIN# 3795090951 DATE June 9 99

OWNER OR CONTRACTOR Clyde Hall Est PHONE: Business 704 664 6400 Home

ADDRESS PO Box 3397 Mooresville NC

LOCATION Old MT Rd N to Cain Rd 3rd House on Left

SUBDIVISION Cain Rd Est BLOCK / SECTION LOT 5 LOT AREA 1.51 Ac SITE CLASS P5 DESIGN FLOW 360 L.T.A.R. 3

Septic Tank: 1000 Gallons; STB 1012 Date 6/2/99
Pump Tank: Gallons; PT Date
Pump Make: Model Serial No.
Nitrification Field: No Fields 1 Square Feet 1200 Linear Feet 300
No Lines 5 @ 60 Trench Width 36" Max Trench Bottom Depth 36

☒ New System ☐ Repair System Type: I. II. III. IV. V. VI
System Description: 25% Reduction GRAVITY
Repair System Description: 50% Reduction
Maintenance Agreement Required: ☐ Yes ☒ No
~~Gravel~~ Depth 5 And 6"

☐ House/Mod. Home ☒ Mobile Home ☐ Business ☐ Other
No. Bedrooms 3 No. Bathrooms 2 No. Employees


☐ Slab ☒ Crawl Space ☐ Basement w/plumbing ☐ Basement wo/plumbing

Water Supply: ☐ Individual ☒ Public ☐ Community


Comments/Conditions: Landscape To provide DRAINAGE
Keep 10' From Prop. Line
50 Chambers or 30 HNS Systems
Call 928 2030 for final

Comments/Conditions:

INITIAL SITE SKETCH

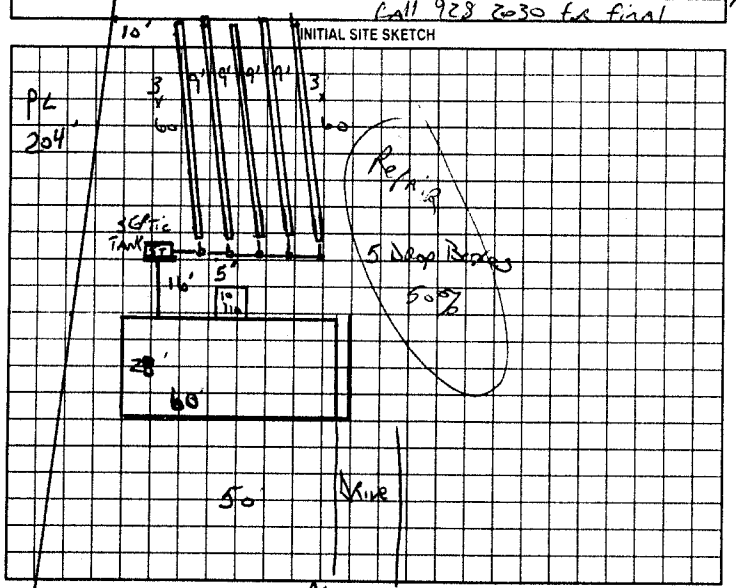

AS BUILT SKETCH

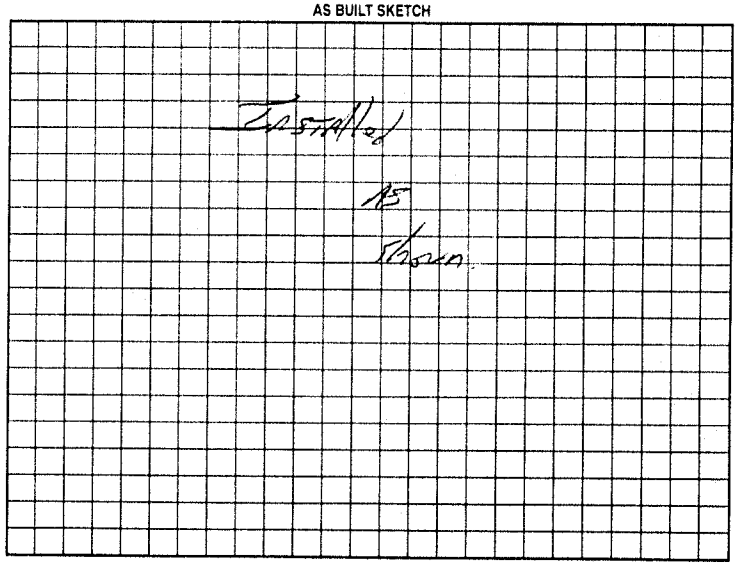

Permit can be suspended or revoked if any false information is supplied toward securing the permit/any unauthorized changes are made to the site/any unauthorized changes are made in the installation of the system. Improvement Permit with plat valid without expiration. Improvement Permit with site plan valid for sixty months. Authorization to ~~Construct~~ is valid for a period equal to that of Improvement Permit - not to exceed sixty months.

Signed: Clyde Hall date 7.16.99

Improvement Permit by: C Potter date 6 9 99

Authorization to Construct by: C Potter date 6 9 99

Installed by: C & W Grading

Operation Permit by: C Potter date 8-20 99

Existing System Inspection by: date

HEALTH DEPT COPY. WHITE OWNER COPY (FINAL) YELLOW OWNER COPY (INITIAL) PINK