This permit voids previously issued permit dated 8/20/03. CI

IREDELL COUNTY HEALTH DEPARTMENT

STATESVILLE 704-878-5305 MOORESVILLE 704-664-5281

IMPROVEMENT PERMIT / AUTHORIZATION TO CONSTRUCT / OPERATION PERMIT / EXISTING SYSTEM INSPECTION

PERMIT# 114246 PIN# 3796-00-4467 DATE 2/17/04

OWNER OR CONTRACTOR Clyde Hall PHONE: Business 924-9393 Home

ADDRESS P.O. Box 3397 Mooresville NC 28117

LOCATION I-40 West; (1) Old Mtn Rd, (2) Can Rd, (3) on Grain Drive on right

SUBDIVISION Can Rd Estates BLOCK / SECTION 3 / LOT 25 LOT AREA .671 Ac SITE CLASS. PS DESIGN FLOW 360 GPD L.T.A.R. .30 gpd

Septic Tank: 4000 Gallons; STB 1012 Date 9-18-03

Pump Tank: Gallons; PT Date

Pump Make: Model Serial No.

Nitrification Field: No Fields 1 Square Feet Equiv 1200 Linear Feet 300

No Lines 4@75 Trench Width 36" Max Trench Bottom Depth 36" Gravel Depth NA

☒ New System ☐ Repair System Type: I, II, III, IV, V, VI w/o

System Description: Gravity, ~~Low Pressure~~

Repair System Description: Pump Low Pressure Panel

Maintenance Agreement Required: ☐ Yes ☒ No

☐ House/Mod. Home ☒ Mobile Home ☐ Business ☐ Other

No. Bedrooms 3 No. Bathrooms 2 No. Employees

☐ Slab ☒ Crawl Space ☐ Basement w/plumbing ☐ Basement wo/plumbing


Water Supply: ☐ Individual ☒ Public ☐ Community

Comments:/Conditions: ① Maintain proper setbacks

Comments:/Conditions: - ST Marker Installed

- Tuff-Tite filter Installed

INITIAL SITE SKETCH

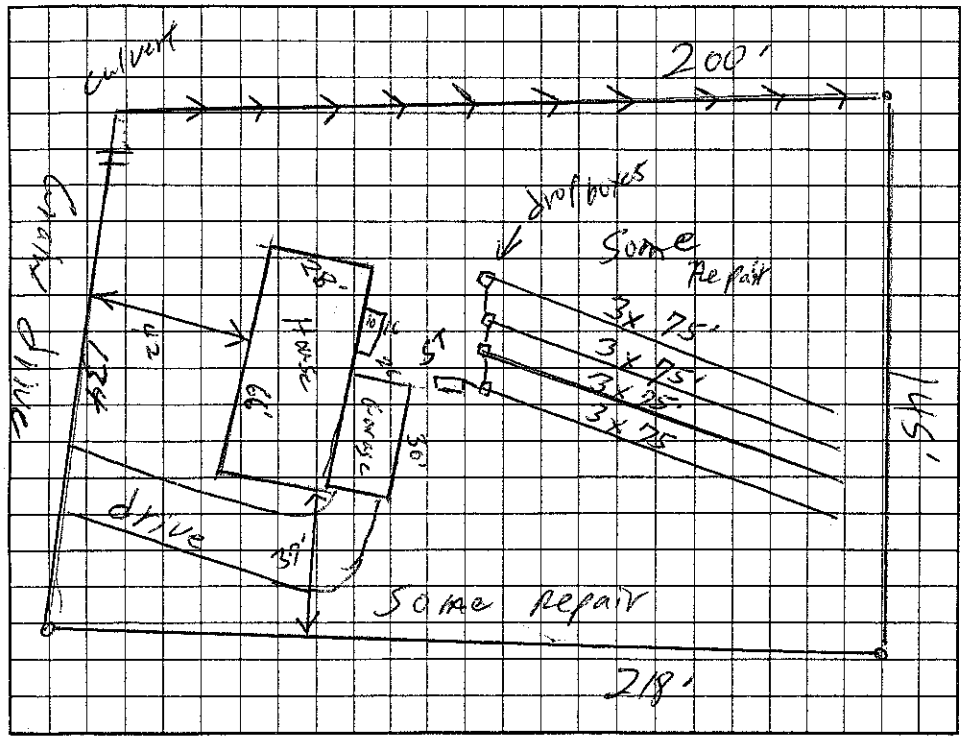

AS BUILT SKETCH

Installed As Shown Per Initial Site Sketch

Permit can be suspended or revoked if any false information is supplied toward securing the permit/any unauthorized changes are made to the site/any unauthorized changes are made in the installation of the system. Improvement Permit with plat valid without expiration. Improvement Permit with site plan valid for sixty months. Authorization to Construct is valid for a period equal to that of Improvement Permit -- not to exceed sixty months.

Signed: Frank Bailey date 2-17-04 Installed by: A-1 Backhoe

Improvement Permit by: William O. Johnson date 2/17/04 Operation Permit by: William O. Johnson date 2/18/04

Authorization to Construct by: William O. Johnson date 2/17/04 Existing System Inspection by: date

HEALTH DEPT. COPY: WHITE OWNER COPY (FINAL): YELLOW OWNER COPY (INITIAL): PINK