IREDELL COUNTY HEALTH DEPARTMENT

STATESVILLE 704-878-5305 MOORESVILLE 704-664-5281

IMPROVEMENT PERMIT / AUTHORIZATION TO CONSTRUCT / OPERATION PERMIT / EXISTING SYSTEM INSPECTION

PERMIT# 80300 PIN# 3795 09 0951 DATE 4-16-99

OWNER OR CONTRACTOR Clyde Hall Enterprizes PHONE: Business 664 6400 Home

ADDRESS Po Box 1556 Mooresville, N.C.

LOCATION Old mtn Rd Turn Cain Rd 600' lft

SUBDIVISION Cains Est. BLOCK / SECTION LOT 4 LOT AREA .5 acre SITE CLASS. PS DESIGN FLOW 360 L.T.A.R. .3

Septic Tank: 1000 Gallons; STB 825 Date 3-15-99
Pump Tank: Gallons; PT Date
Pump Make: Model Serial No.
Nitrification Field: No Fields 1 Square Feet 900 Linear Feet 300
No Lines 4 Trench Width 36" Max Trench Bottom Depth 36" Gravel Depth N/A

☑ New System ☐ Repair System Type: I (II) III, IV, V, VI
System Description: Gravity 25% Reduction
Repair System Description: " " "
Maintenance Agreement Required: ☐ Yes ☑ No


☐ House/Mod. Home No. Bedrooms 3
☑ Mobile Home No. Bathrooms 2
☐ Business No. Employees
☐ Other
☐ Slab ☐ Crawl Space ☐ Basement w/plumbing ☐ Basement wo/plumbing

Water Supply: ☐ Individual ☑ Public ☐ Community


Comments/Conditions:

Comments/Conditions

INITIAL SITE SKETCH PB 201.96

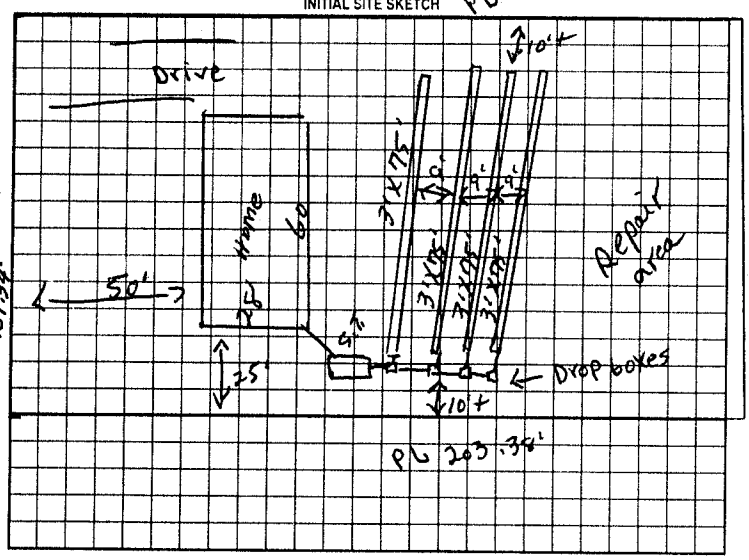

AS BUILT SKETCH

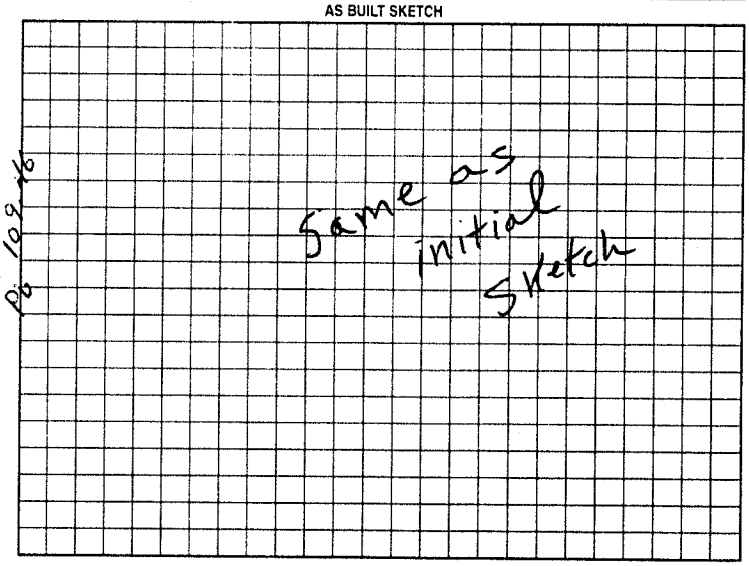

Permit can be suspended or revoked if any false information is supplied toward securing the permit/any unauthorized changes are made to the site/any unauthorized changes are made in the installation of the system. Improvement Permit with plat valid without expiration. Improvement Permit with site plan valid for sixty months. Authorization to Construct is valid for a period equal to that of Improvement Permit – not to exceed sixty months.

Signed: Ben Stikeleather date 5-6-99 Installed by: Rowan S.T. Co.

Improvement Permit by: F. C. Moore date 5-6-99 Operation Permit by: F. C. Moore date 6-11-99

Authorization to Construct by: date Existing System Inspection by: date

HEALTH DEPT COPY: WHITE OWNER COPY (FINAL): YELLOW OWNER COPY (INITIAL): PINK