IREDELL COUNTY HEALTH DEPARTMENT

STATESVILLE 704-878-5305 MOORESVILLE 704-664-5281

IMPROVEMENT PERMIT / AUTHORIZATION TO CONSTRUCT / OPERATION PERMIT / EXISTING SYSTEM INSPECTION

PERMIT# 80299 PIN# 3705 09 0951 DATE 4-16-99

OWNER OR CONTRACTOR Clyde Hall Enterprizes PHONE: Business 664 6400 Home

ADDRESS PO Box 1556 mooresville, N.C.

LOCATION Old mtn Rd To Cain Rd 500' Left

SUBDIVISION Cane Rd Est BLOCK / SECTION 1 LOT 3 LOT AREA .5 acres SITE CLASS PS DESIGN FLOW 360 L.T.A.R. 3

Septic Tank: 1000 Gallons; STB 625 Date 3-15-99
Pump Tank: Gallons; PT Date
Pump Make: Model Serial No.
Nitrification Field: No Fields 1 Square Feet 900 Linear Feet 300
No Lines 4 Trench Width 36" Max Trench Bottom Depth 36" Gravel Depth N/A

☑ New System ☐ Repair System Type: I ☑ II III IV V VI
System Description: Gravity 25% Reduction
Repair System Description:
Maintenance Agreement Required: ☐ Yes ☑ No

☐ House/Mod. Home ☑ Mobile Home ☐ Business ☐ Other
No. Bedrooms 3 No. Bathrooms 2 No. Employees

☐ Slab ☑ Crawl Space ☐ Basement w/plumbing ☐ Basement wo/plumbing


Water Supply: ☐ Individual ☑ Public ☐ Community

Comments/Conditions:

PL 200.84'

Comments/Conditions

INITIAL SITE SKETCH

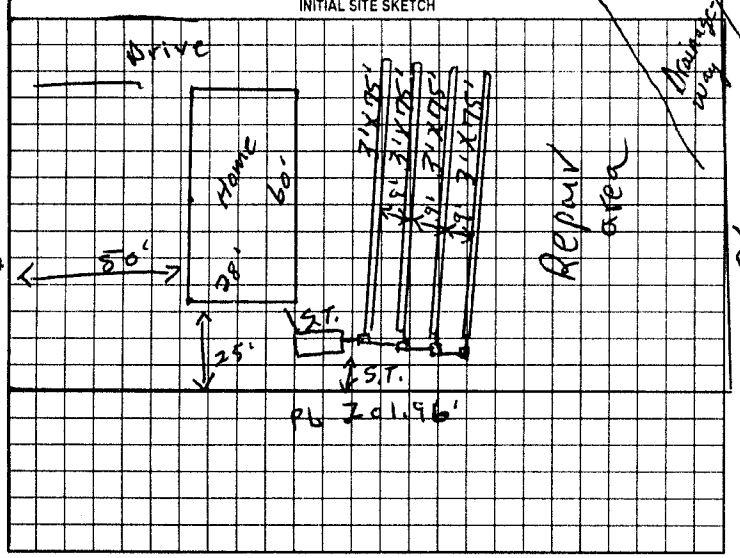

AS BUILT SKETCH

Same as initial sketch

Permit can be suspended or revoked if any false information is supplied toward securing the permit/any unauthorized changes are made to the site/any unauthorized changes are made in the installation of the system. Improvement Permit with plat valid without expiration; Improvement Permit with site plan valid for sixty months. Authorization to Construct is valid for a period equal to that of Improvement Permit – not to exceed sixty months.

Signed: Ben Hyatt date 5-6-99 Installed by: Rowan S.T.

Improvement Permit by: P. C. Moore date 4-16-99 Operation Permit by: P. C. Moore date 6-11-99

Authorization to Construct by: P. C. Moore date 4-16-99 Existing System Inspection by: date

HEALTH DEPT COPY WHITE OWNER COPY (FINAL) YELLOW OWNER COPY (INITIAL) PINK