IREDELL COUNTY HEALTH DEPARTMENT

STATESVILLE 704-878-5305 (A) MOORESVILLE 704-664-5281

IMPROVEMENT PERMIT / AUTHORIZATION TO CONSTRUCT / OPERATION PERMIT / EXISTING SYSTEM INSPECTION

PERMIT# 133831 PIN# 3796006050 DATE 2-28-06

OWNER OR APPLICANT First Choice Housing PHONE: Business 704 883-8228 Home

ADDRESS 137 Grain Dr.

LOCATION 40 West, Old Mountain Rd, right 8 miles left Cain Rd - 1st left Grain Dr. - 5th lot on left

SUBDIVISION Cain Road Estates BLOCK / SECTION III LOT 31 LOT AREA .573 SITE CLASS. PS DESIGN FLOW 360 L.T.A.R. .3

Septic Tank: 1000 Gallons: STB 317 Date 3-10-06
Pump Tank: 1000 Gallons: PT 245 Date 3-10-06
Pump Make: Little Giant Model Serial No.
Nitrification Field: No Fields 1 Square Feet 1200 Linear Feet 400
No Lines 4 Trench Width 3 Max Trench Bottom Depth 36

☒ New System ☐ Repair ☐ Expansion System Type: I II (III) IV V VI
System Description: Pump Conventional
Repair System Description: Pump 25% Reduction
Maintenance Agreement Required: ☐ Yes ☒ No

☒ House/Mod. Home No. Bedrooms 3
☐ Mobile Home No. Persons
☐ Business No. Employees
☐ Other


Water Supply: ☐ Individual ☒ Public ☐ Community

Gravel Depth 12 ☐ Gravity ☒ Pressure ☐ Slab ☒ Crawl Space ☐ Basement w/plumbing ☐ Basement wo/plumbing


Comments/Conditions: An approved system may also be used.

Comments/Conditions:

INITIAL SITE SKETCH

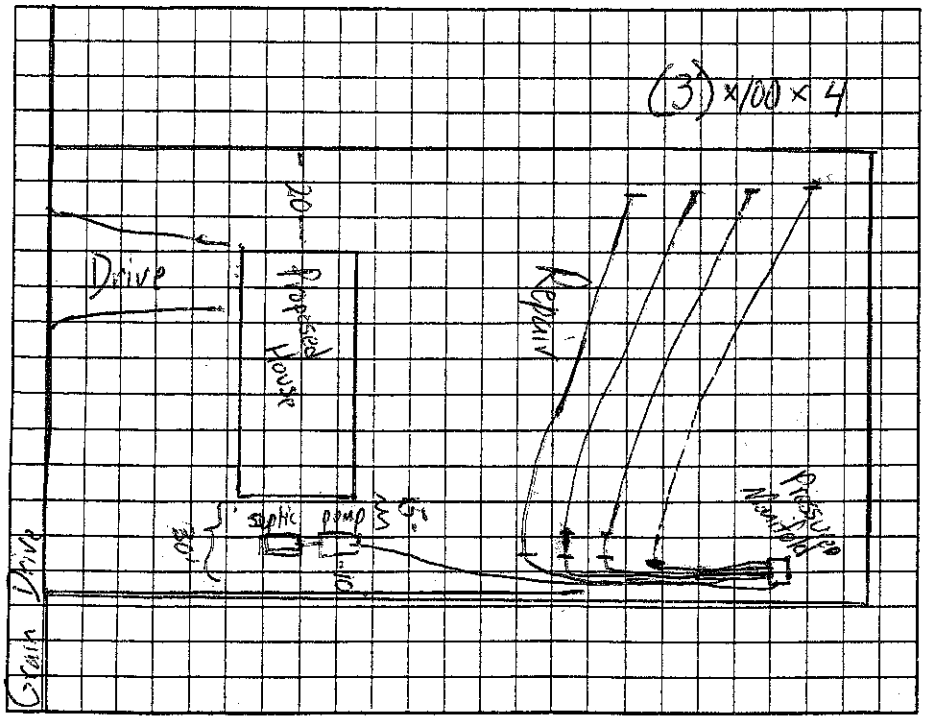

AS BUILT SKETCH

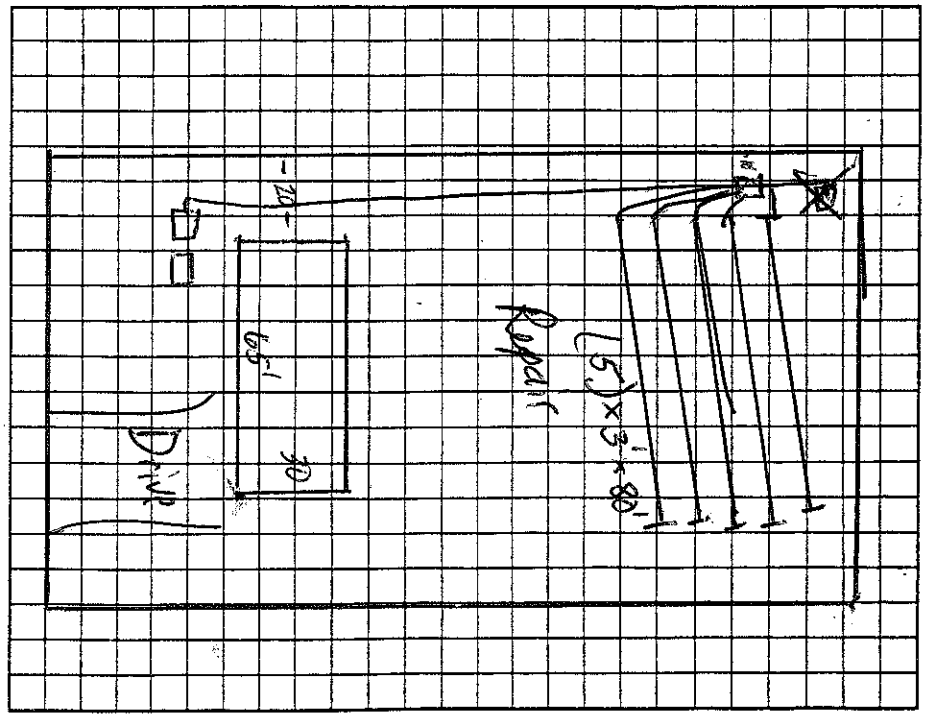

Permit can be suspended or revoked if any false information is supplied toward securing the permit/any unauthorized changes are made to the site/any unauthorized changes are made in the installation of the system. Improvement Permit with plat valid without expiration ☐ Improvement Permit with site plan valid for sixty months ☐ Authorization to Construct is valid for a period equal to that of Improvement Permit – not to exceed sixty months.

Signed: [signature] date

Improvement Permit by: [signature] date 3-1-06

Authorization to Construct by: [signature] date 3-1-06

Installed by: Bob's Backhoe

Operation Permit by: STEVE HEDRICK date 7-27-06

Existing System Inspection by: date

HEALTH DEPT. COPY: WHITE OWNER COPY (FINAL): YELLOW OWNER COPY (INITIAL): PINK