IREDELL COUNTY HEALTH DEPARTMENT

STATESVILLE 704-878-5305 CI MOORESVILLE 704-664-5281

IMPROVEMENT PERMIT / AUTHORIZATION TO CONSTRUCT / OPERATION PERMIT / EXISTING SYSTEM INSPECTION

PERMIT# 114255 PIN# 3796-00-7303 DATE 6/26/04

OWNER OR CONTRACTOR Clyde Hall Enterprise PHONE: Business (704) 664-6400 Home —

ADDRESS P.O. Box 3393 Mooresville N.C. 28117

LOCATION I-40 W to Exit #54 N Rt 21 Rt Cain Rd Rt Crain Drive, 2nd lot on left

SUBDIVISION Cain Rd Estates BLOCK / SECTION 3 LOT 28 LOT AREA .5573 Acre SITE CLASS. P5 DESIGN FLOW 360 L.T.A.R. .30 gpd/ft²

Septic Tank: 4000 Gallons; STB 1007 Date 4-5-04
Pump Tank: 4000 Gallons; PT 274 Date 7-1-04
Pump Make: Gentes Model ½ HP Serial No. —
Nitrification Field: No Fields 1 Square Feet 1200 Linear Feet 400
No Lines 4 Trench Width 36" Max Trench Bottom Depth 32" Gravel Depth ~~24~~ 17"

☒ New System ☐ Repair System Type: I, II, III, IV, V, VI
System Description: Pump Conventional
Repair System Description: Pump 25% Reduction
Maintenance Agreement Required: ☐ Yes ☒ No


☒ House/Mod. Home No. Bedrooms 3
☐ Mobile Home No. Bathrooms 2
☐ Business No. Employees
☐ Other
☐ Slab ☒ Crawl Space ☐ Basement w/plumbing ☐ Basement wo/plumbing

Water Supply: ☐ Individual ☒ Public ☐ Community

Comments:/Conditions: ① Install liner on contour

Comments:/Conditions:
Label Filter Installed
ST marker Installed
Pressure Check okay, E+A okay 12/17/04)

INITIAL SITE SKETCH

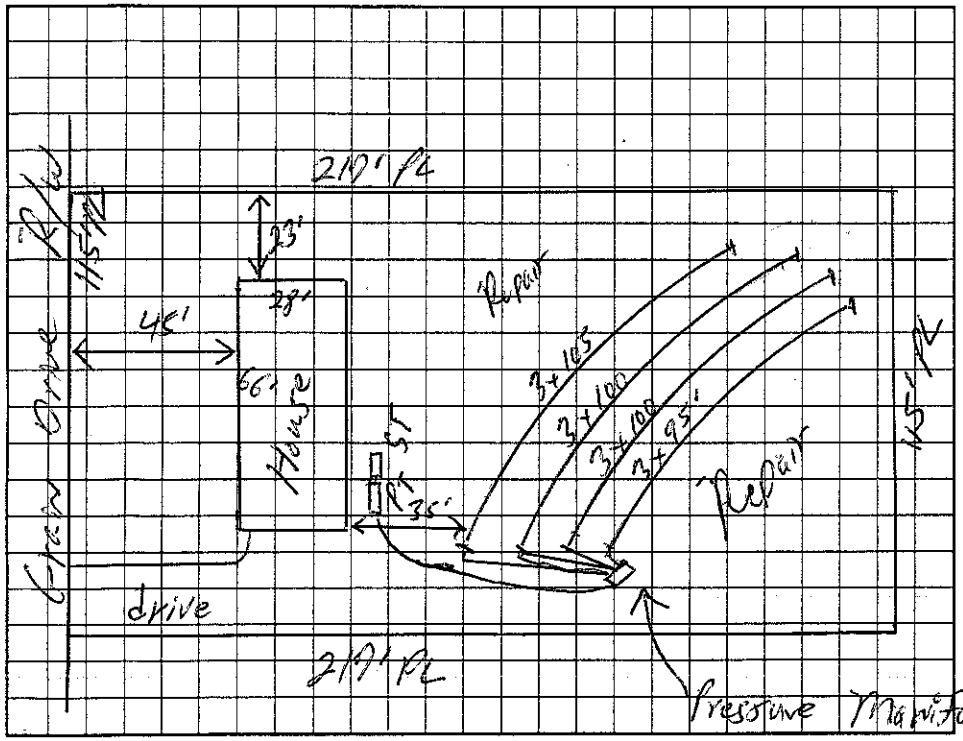

AS BUILT SKETCH

Installed As Shown per Initial Site Sketch

Permit can be suspended or revoked if any false information is supplied toward securing the permit/any unauthorized changes are made to the site/any unauthorized changes are made in the installation of the system. Improvement Permit with plat valid without expiration. Improvement Permit with site plan valid for sixty months. Authorization to Construct is valid for a period equal to that of Improvement Permit – not to exceed sixty months.

Signed: Ken Walters date 7/14/04 Installed by: Tommy Cothren (8/24/04)

Improvement Permit by: William O. Johnson date 6/26/04 Operation Permit by: William O. Johnson date 12/17/04

Authorization to Construct by: William O. Johnson date 6/26/04 Existing System Inspection by: date

HEALTH DEPT. COPY: WHITE OWNER COPY (FINAL): YELLOW OWNER COPY (INITIAL): PINK