IREDELL COUNTY HEALTH DEPARTMENT

STATESVILLE 704-878-5305 (C\) MOORESVILLE 704-664-5281

IMPROVEMENT PERMIT / AUTHORIZATION TO CONSTRUCT / OPERATION PERMIT / EXISTING SYSTEM INSPECTION

PERMIT# 114254 PIN# 3796 00 7425 DATE 8/20/03

OWNER OR CONTRACTOR CLYDE HALL PHONE: Business 924-9393 Home

ADDRESS PO BOX 3397 MOORESVILLE NC 28117

LOCATION 40 EAST - TO OLD MOUNTAIN RD - TR OLD MOUNTAIN RD - TL CAIN RD - TL GRAIN RD - ON LT

SUBDIVISION CAIN RD ESTATES BLOCK / SECTION LOT 27 LOT AREA .622 AC SITE CLASS. PS DESIGN FLOW 360 GPD L.T.A.R. .2560 SQ FT

Septic Tank: 1000 Gallons; STB 1007 Date 1-7-05
Pump Tank: 1000 Gallons; PT 274 Date 1-24-05
Pump Make: GOULDS Model WE0311M Serial No. A0544039
Nitrification Field: No Fields 1 Square Feet 1440 Linear Feet 480
No Lines 5@96' Trench Width 36" Max Trench Bottom Depth 26" Gravel Depth 18"

☑ New System ☐ Repair System Type: I, II, (III), IV, V, VI
System Description: PUMP CONVENTIONAL
Repair System Description: PUMP 25% REDUCTION
Maintenance Agreement Required: ☐ Yes ☑ No

☑ House/Mod. Home No. Bedrooms 3
☐ Mobile Home No. Bathrooms 3
☐ Business No. Employees
☐ Other


☐ Slab ☑ Crawl Space ☐ Basement w/plumbing ☐ Basement wo/plumbing

Water Supply: ☐ Individual ☑ Public ☐ Community


Comments:/Conditions:

Comments:/Conditions: Approved 26'6" X 56' HOUSE, MAINTAIN SETBACKS. LL 1-25-05
SEPTIC TANK WITH MARKER INSTALLED
USING "ZABEL" FILTER

INITIAL SITE SKETCH 1" = 50'

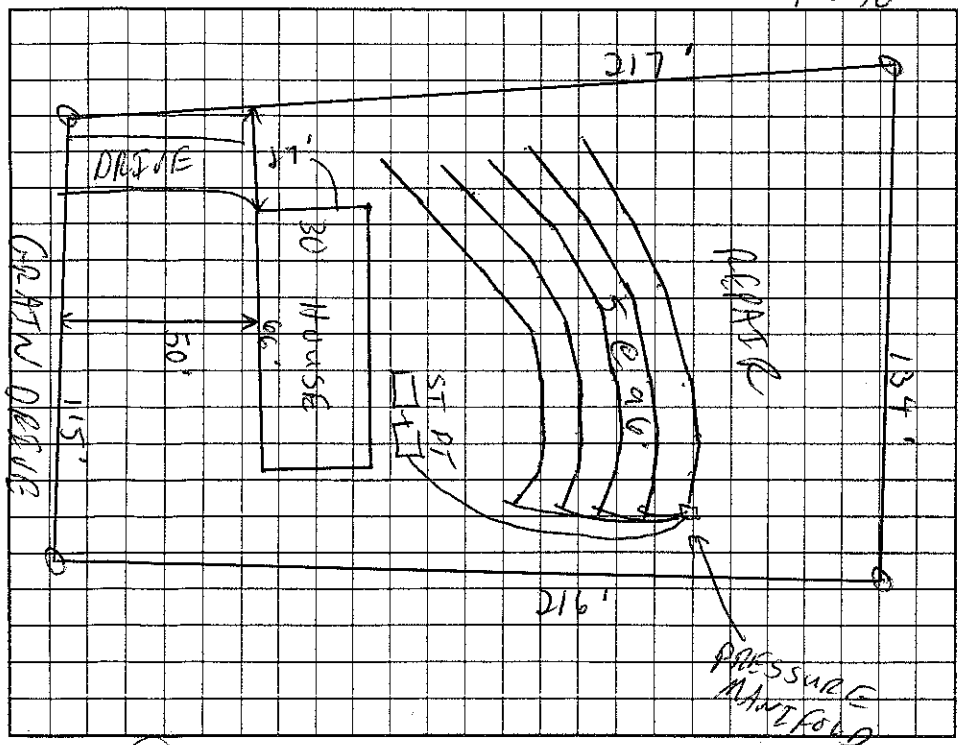

AS BUILT SKETCH

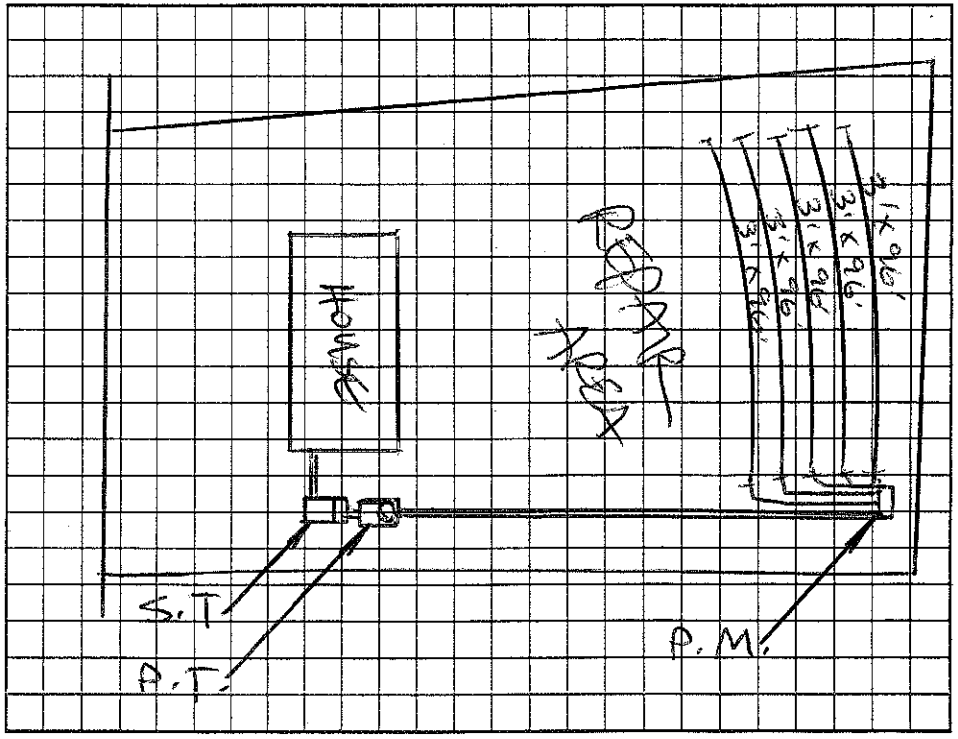

Permit can be suspended or revoked if any false information is supplied toward securing the permit/any unauthorized changes are made to the site/any unauthorized changes are made in the installation of the system. Improvement Permit with plat valid without expiration. Improvement Permit with site plan valid for sixty months. Authorization to Construct is valid for a period equal to that of Improvement Permit – not to exceed sixty months.

Signed: Clyde R Hall date 9-24-03 Installed by: TOMMY COTHREN

Improvement Permit by: RS date 8/20/03 Operation Permit by: STEVE HENDRICK date 5-11-05

Authorization to Construct by: RS date 1-25-05 Existing System Inspection by: date

HEALTH DEPT. COPY: WHITE OWNER COPY (FINAL): YELLOW OWNER COPY (INITIAL): PINK