IREDELL COUNTY HEALTH DEPARTMENT - *ENVIRONMENTAL HEALTH* ☒ STATESVILLE OFFICE 704-878-5305 ☐ MOORESVILLE OFFICE 704-664-5281

IMPROVEMENT PERMIT / AUTHORIZATION TO CONSTRUCT / OPERATION PERMIT / EXISTING SYSTEM INSPECTION

PERMIT # Repair PIN # 3796-21-9293 DATE 5-18-11

OWNER Emily Willoughby APPLICANT:

SITE ADDRESS 370 Lindsey Farm Rd. PHONE: Home/Cell # 704-402-2790 Business #

SITE DIRECTIONS Old Mtn Rd (N) to (R) on Lindsay Farm Rd, 1st brick house on left OWNER / APPLICANT ADDRESS

SUBDIVISION n/a BLOCK / SECTION n/a LOT # n/a LOT AREA 1.77 DESIGN FLOW Ex 360 L.T.A.R. Ex

Septic Tank 1000 Gallons: STB 760 Date 2-1-11

Pump Tank Gallons: P T Date

Pump Make Model Serial #

No. Nitrification Fields: Ex No. Lines Ex Linear Feet Ex

Trench Width Ex Max. Trench Bottom Depth Ex Gravel Depth Ex

☐ New System ☒ Repair ☐ Expansion System Type I II III IV V VI

System Description:

Repair System Description: Tank Replacement

Maintenance Agreement Required ☐ YES ☒ NO

☒ GRAVITY ☐ PRESSURE

☒ Residence No. Bedrooms 3

☐ Business No. Persons

☐ Other No. Employees


☐ Slab ☒ Crawl Space

☐ Basement w/plumbing ☐ Basement w/o plumbing


Water Supply: ☒ Private ☐ Public ☐ Community

Comments / Conditions crush and fill existing tank. place new tank in designated area

INITIAL SITE SKETCH

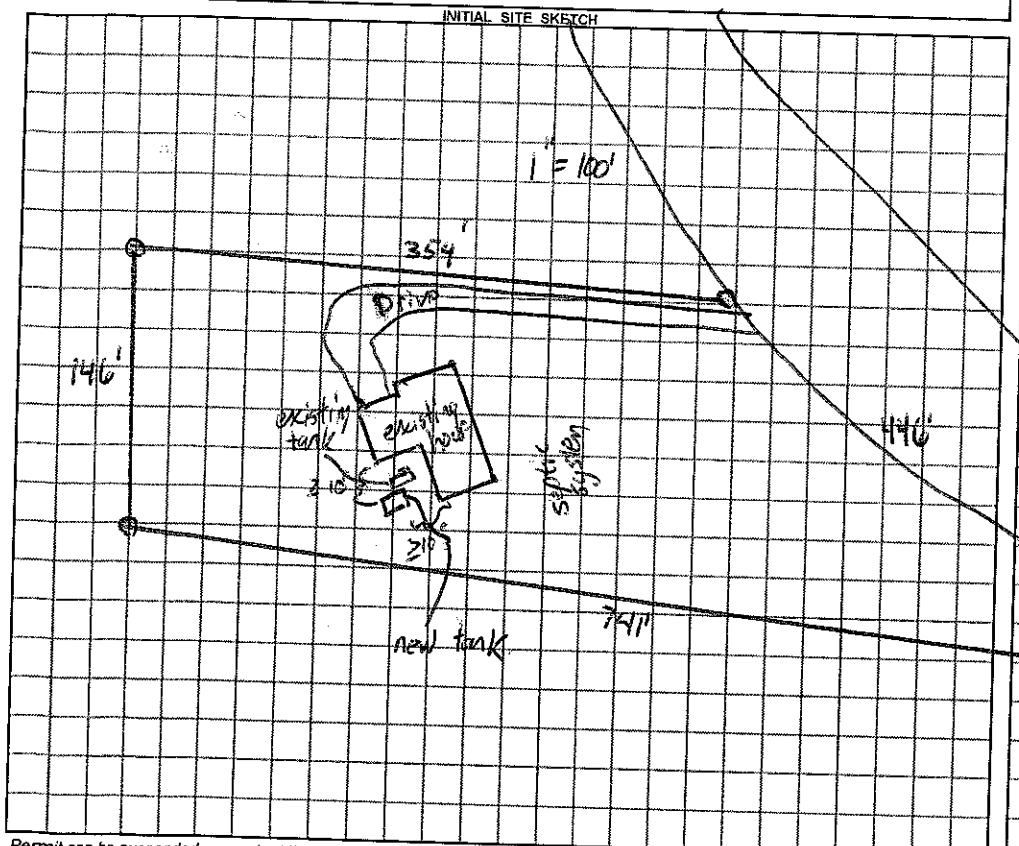

AS BUILT SKETCH

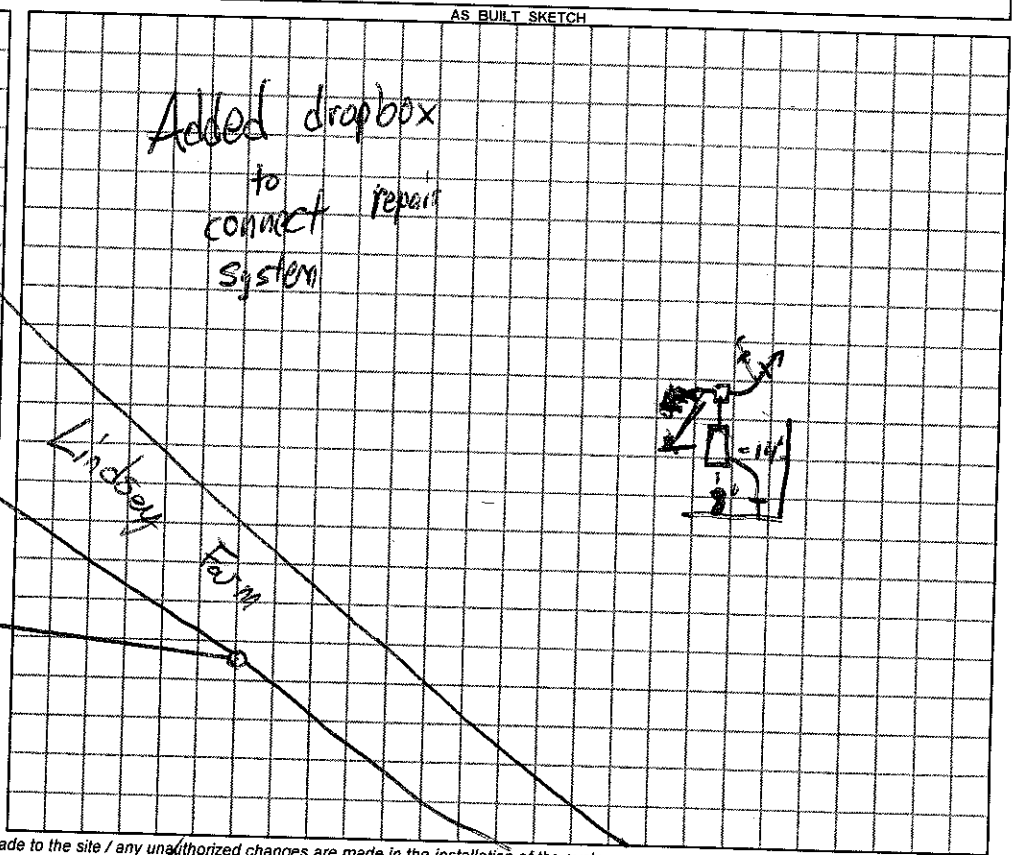

Permit can be suspended or revoked if any false information is supplied toward securing the permit / any unauthorized changes are made to the site / any unauthorized changes are made in the installation of the system.

☐ ***IMPROVEMENT PERMIT*** with plat valid without expiration. ☒ ***IMPROVEMENT PERMIT*** with plat valid without expiration. Site plan valid 60 mo. ☒ ***AUTHORIZATION TO CONSTRUCT*** valid for period equal to IMPROVEMENT PERMIT--not to exceed 60 mo.

Owner / Applicant Signature: George Willoughby Jr. Date 5-18-11 Installed by: A-1 Backhoe

IMPROVEMENT PERMIT by: REHS Date

AUTHORIZATION TO CONSTRUCT by: REHS Date 5-18-11 OPERATION PERMIT by: REHS Date 5-24-11

YOU SHOULD CONTACT A LOCATOR SERVICE PRIOR TO ANY EXCAVATION

Existing System Inspected by: REHS Date

White Copy -- Environmental Health YELLOW COPY (Final) Owner / Applicant PINK COPY (Initial) Owner / Applicant