77572

IREDELL COUNTY HEALTH DEPARTMENT

STATESVILLE 704-878-5305 MOORESVILLE 704-664-5281

IMPROVEMENT PERMIT / CERTIFICATE OF COMPLETION / OPERATION PERMIT / EXISTING SYSTEM INSPECTION

PROPERTY DESCRIPTION NO. 25177 DATE 12-7-96 TAX MAP NO. (Pt) 84-A-76

OWNER OR CONTRACTOR Clyde Hall PHONE: Business 585-2728 Home

ADDRESS Po Box 1556 mooresville Watershed: ☐ Yes ☒ No

LOCATION olt mtn Rd TR Lindsey Fm Rd TR Barley Ln TR millet Dr. 5th lot Rt

SUBDIVISION Lindsey Fm BLOCK / SECTION LOT 26 LOT AREA .1847 acres SITE CLASS. P5 DESIGN FLOW 360 L.T.A.R. 1.25

Septic Tank: 1000 Gallons; STB 1012 Date 7-24-98

Pump Tank: Gallons; PT Date

Pump Make: Model Serial No.

Nitrification Field: No Fields 1 Square Feet 1080 Linear Feet 360

No Lines 4 Trench Width 36 Max Trench Bottom Depth 36

☒ New System ☐ Repair System Type: I, II, III, IV, V, VI

System Description: Gravity chambers

Repair System Description: " "

Maintenance Agreement Required: ☐ Yes ☒ No

Gravel Depth N/A ☐ Slab ☐ Crawl Space ☐ Basement w/plumbing ☐ Basement wo/plumbing


☐ House/Mod. Home ☒ Mobile Home ☐ Business ☐ Other

No. Bedrooms 3 No. Bathrooms 2 No. Employees

Water Supply: ☒ Individual ☐ Community ☐ Public


Comments:

INITIAL SITE SKETCH

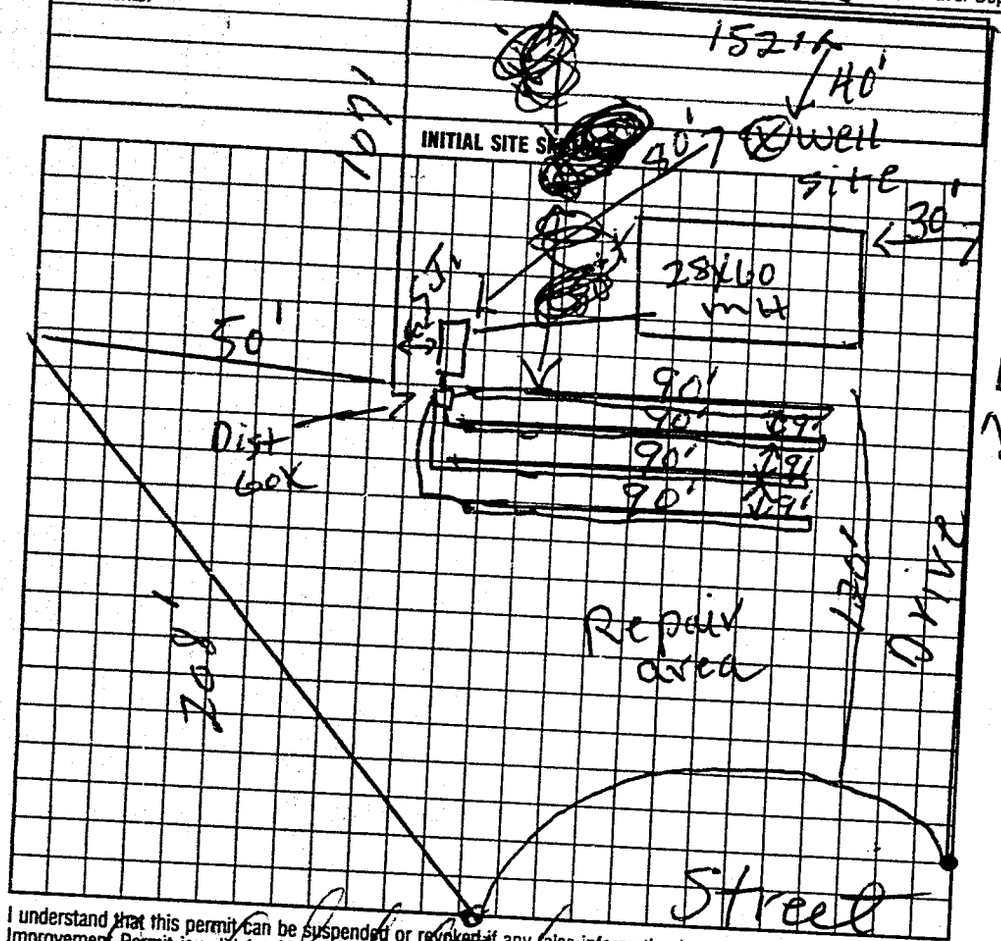

Comments:

AS BUILT SKETCH

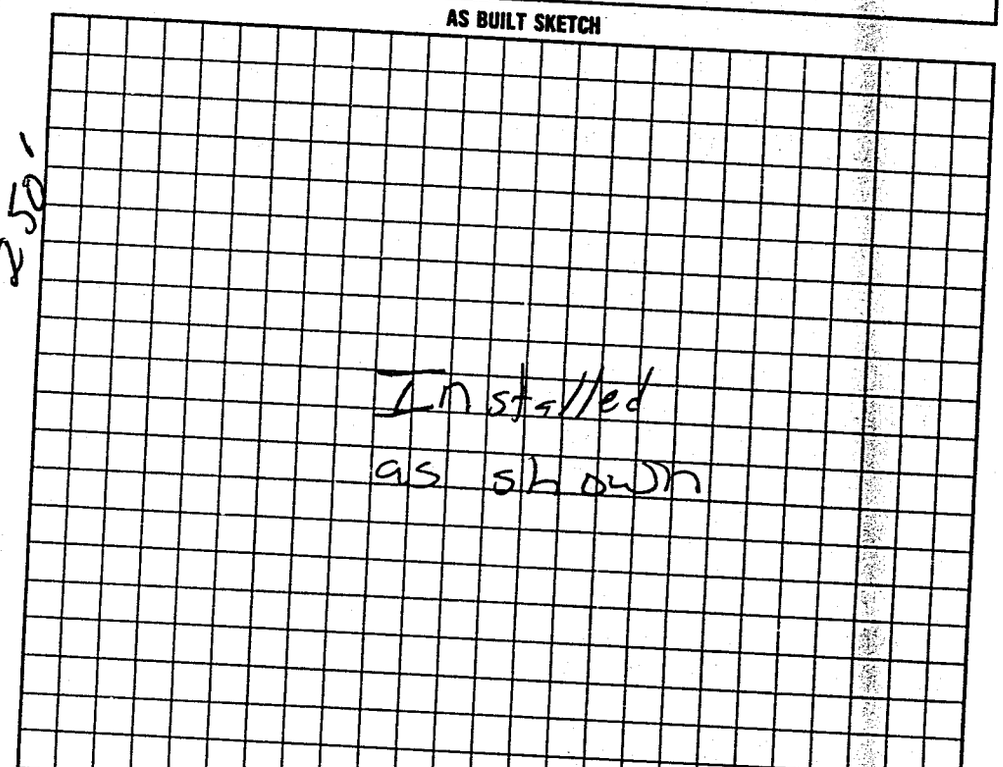

I understand that this permit can be suspended or revoked if any false information is supplied toward securing the permit/any unauthorized changes are made to the site/any unauthorized changes are made in the installation of the system. Improvement Permit is valid for 60 months from date of issuance.

Signed: Clyde Hall

Improvement Permit by: R.C. Moore date 12-7-96

Authorized Existing System Inspection by: R.C. Moore date 12-7-96

to count.

Installed by: Kenny Madison

Certificate of Completion by: date

Operation Permit by: Matt Cox RS date 9-24-98

HEALTH DEPT. COPY: WHITE INSPECTION COPY (FINAL): GREEN OWNER COPY (FINAL): YELLOW INSPECTION COPY (INITIAL): PINK OWNER COPY (INITIAL): GOLD

Authorization to count expires 60 mos from issued