IREDELL COUNTY HEALTH DEPARTMENT

STATESVILLE 704-878-5305 MOORESVILLE 704-664-5281

IMPROVEMENT PERMIT / CERTIFICATE OF COMPLETION / OPERATION PERMIT / EXISTING SYSTEM INSPECTION

PROPERTY DESCRIPTION NO. 2517675926 DATE 12-17-96 TAX MAP NO. pt 8U-A-76 Watershed: ☐ Yes ☑ No

OWNER OR CONTRACTOR Clyde Hall

ADDRESS PO Box 1556 Mooresville N.C. PHONE: Business 585 2728 Home

LOCATION Old Mtn Rd TR Lindsey Fm Rd TR Barley Ln TR Millet 4th lot Rt

SUBDIVISION Lintsey Fm BLOCK / SECTION LOT 25 LOT AREA .717 acres SITE CLASS. PS DESIGN FLOW 360 L.T.A.R. .3

Septic Tank: 1000 Gallons; STB 825 Date 6-29-98

Pump Tank: Gallons; PT Date

Pump Make: Model Serial No.

Nitrification Field: No Fields 1 Square Feet 900 Linear Feet 300

No Lines 4 Trench Width 36" Max Trench Bottom Depth 36" Gravel Depth N/A

☑ New System ☐ Repair System Type: I, II, (III), IV, V, VI

System Description: ~~Con~~ Gravity Chambers

Repair System Description: " "

Maintenance Agreement Required: ☐ Yes ☑ No

☐ Slab ☑ Crawl Space ☐ Basement w/plumbing ☐ Basement wo/plumbing

☐ House/Mod. Home ☑ Mobile Home ☐ Business ☐ Other


No. Bedrooms 3 No. Bathrooms 2 No. Employees

Water Supply: ☑ Individual ☐ Community ☐ Public


Comments:

Comments:

INITIAL SITE SKETCH

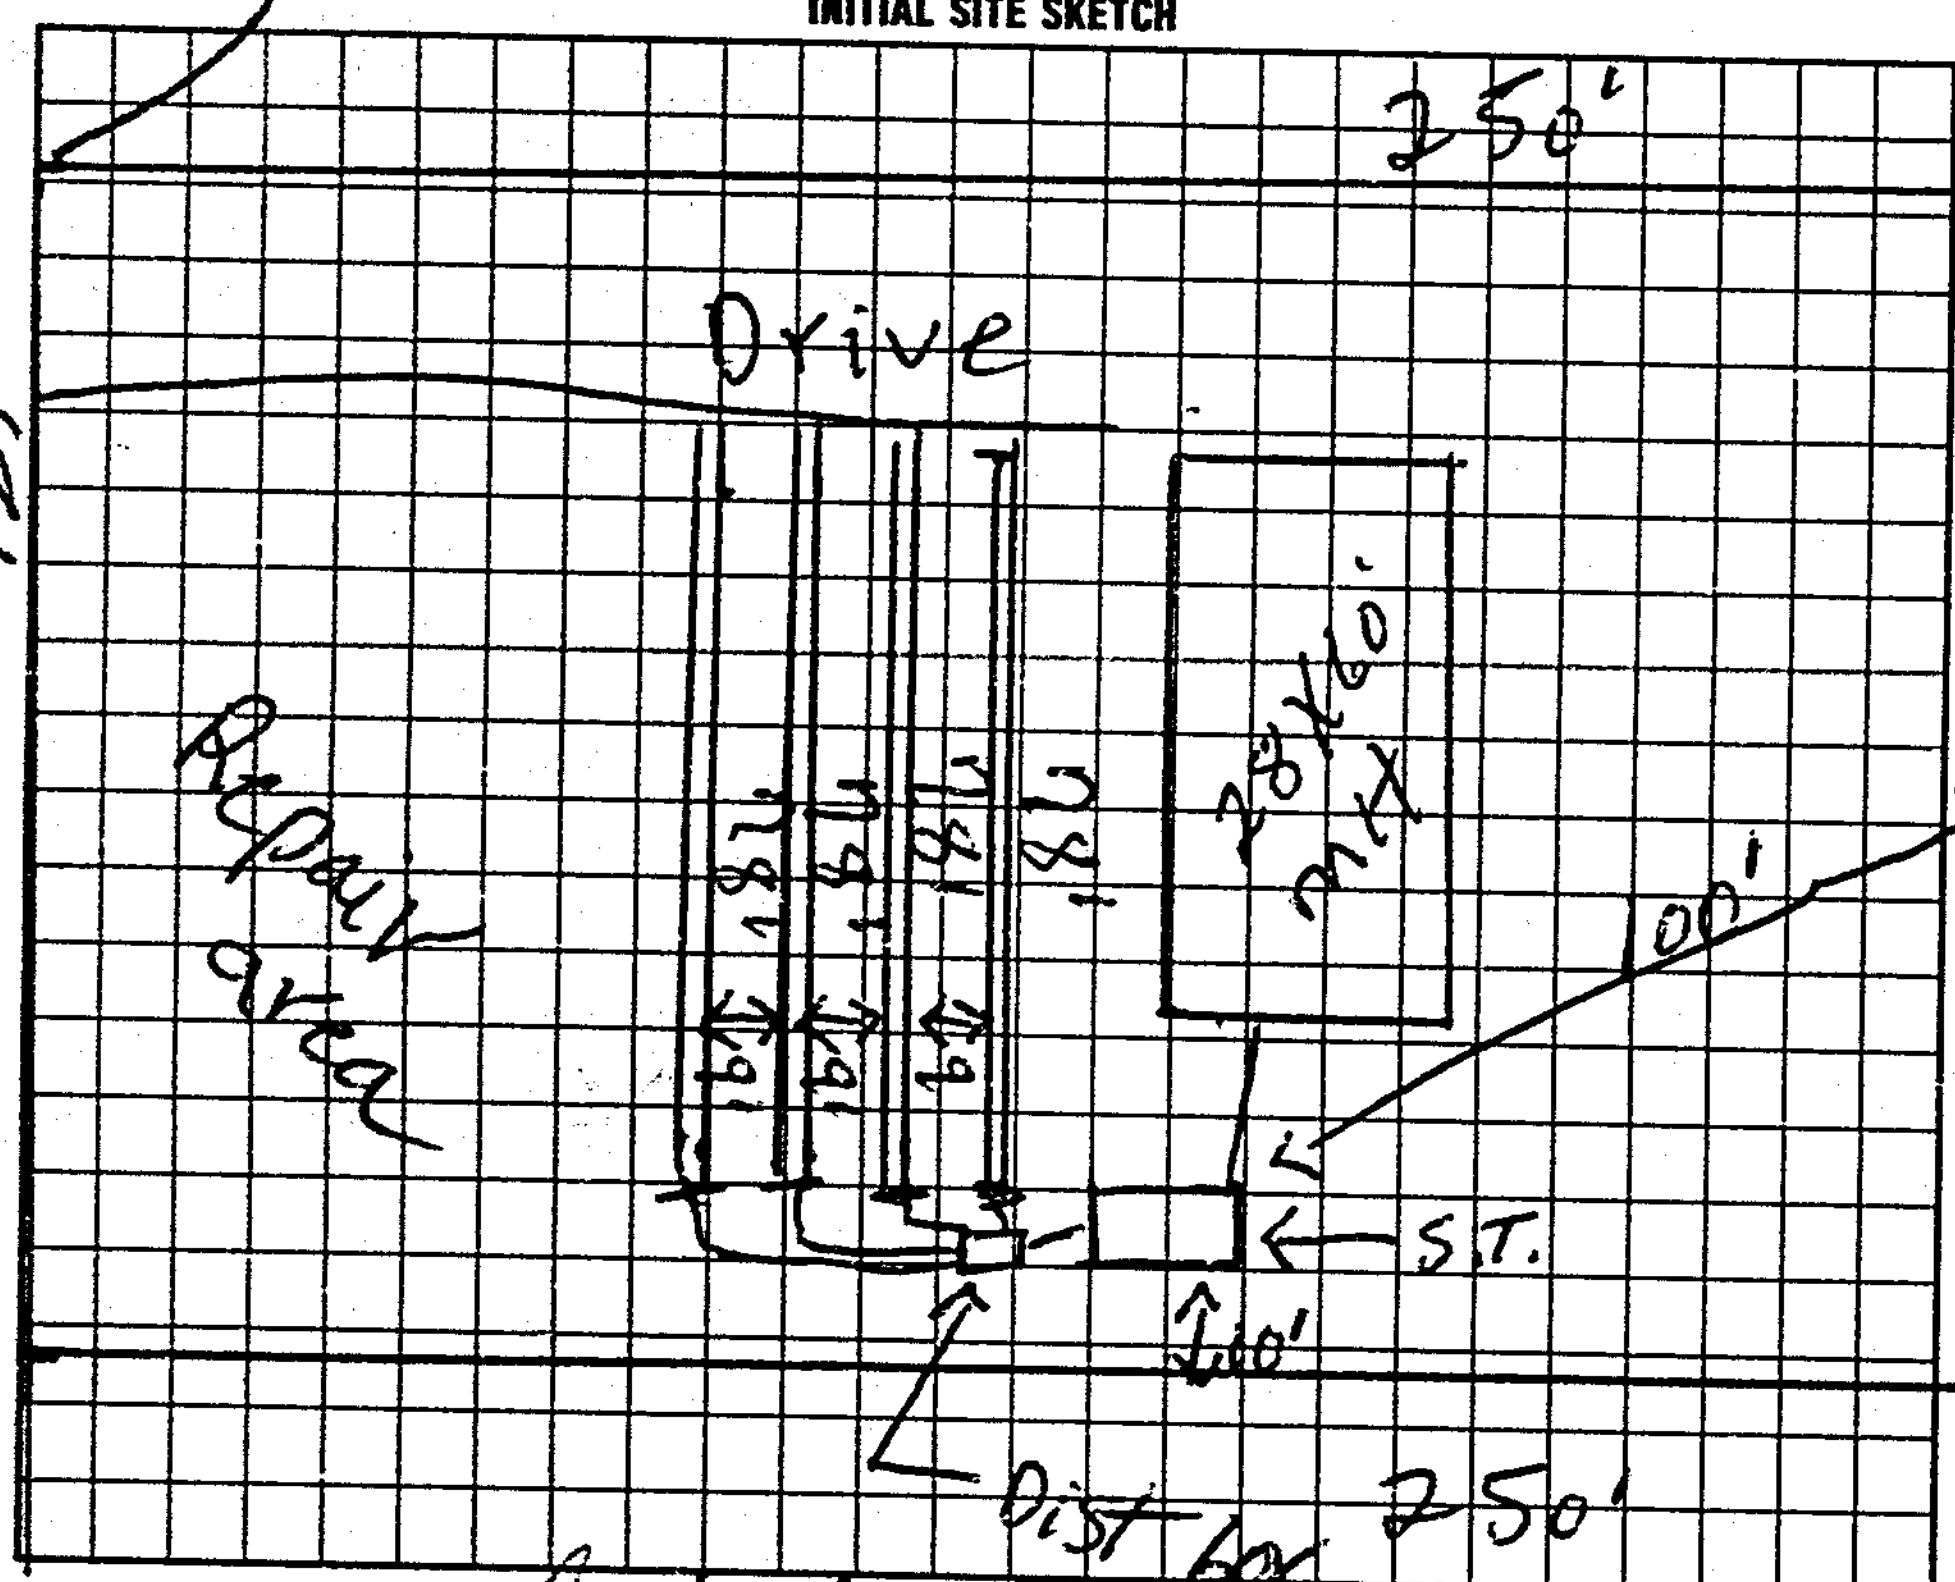

AS BUILT SKETCH

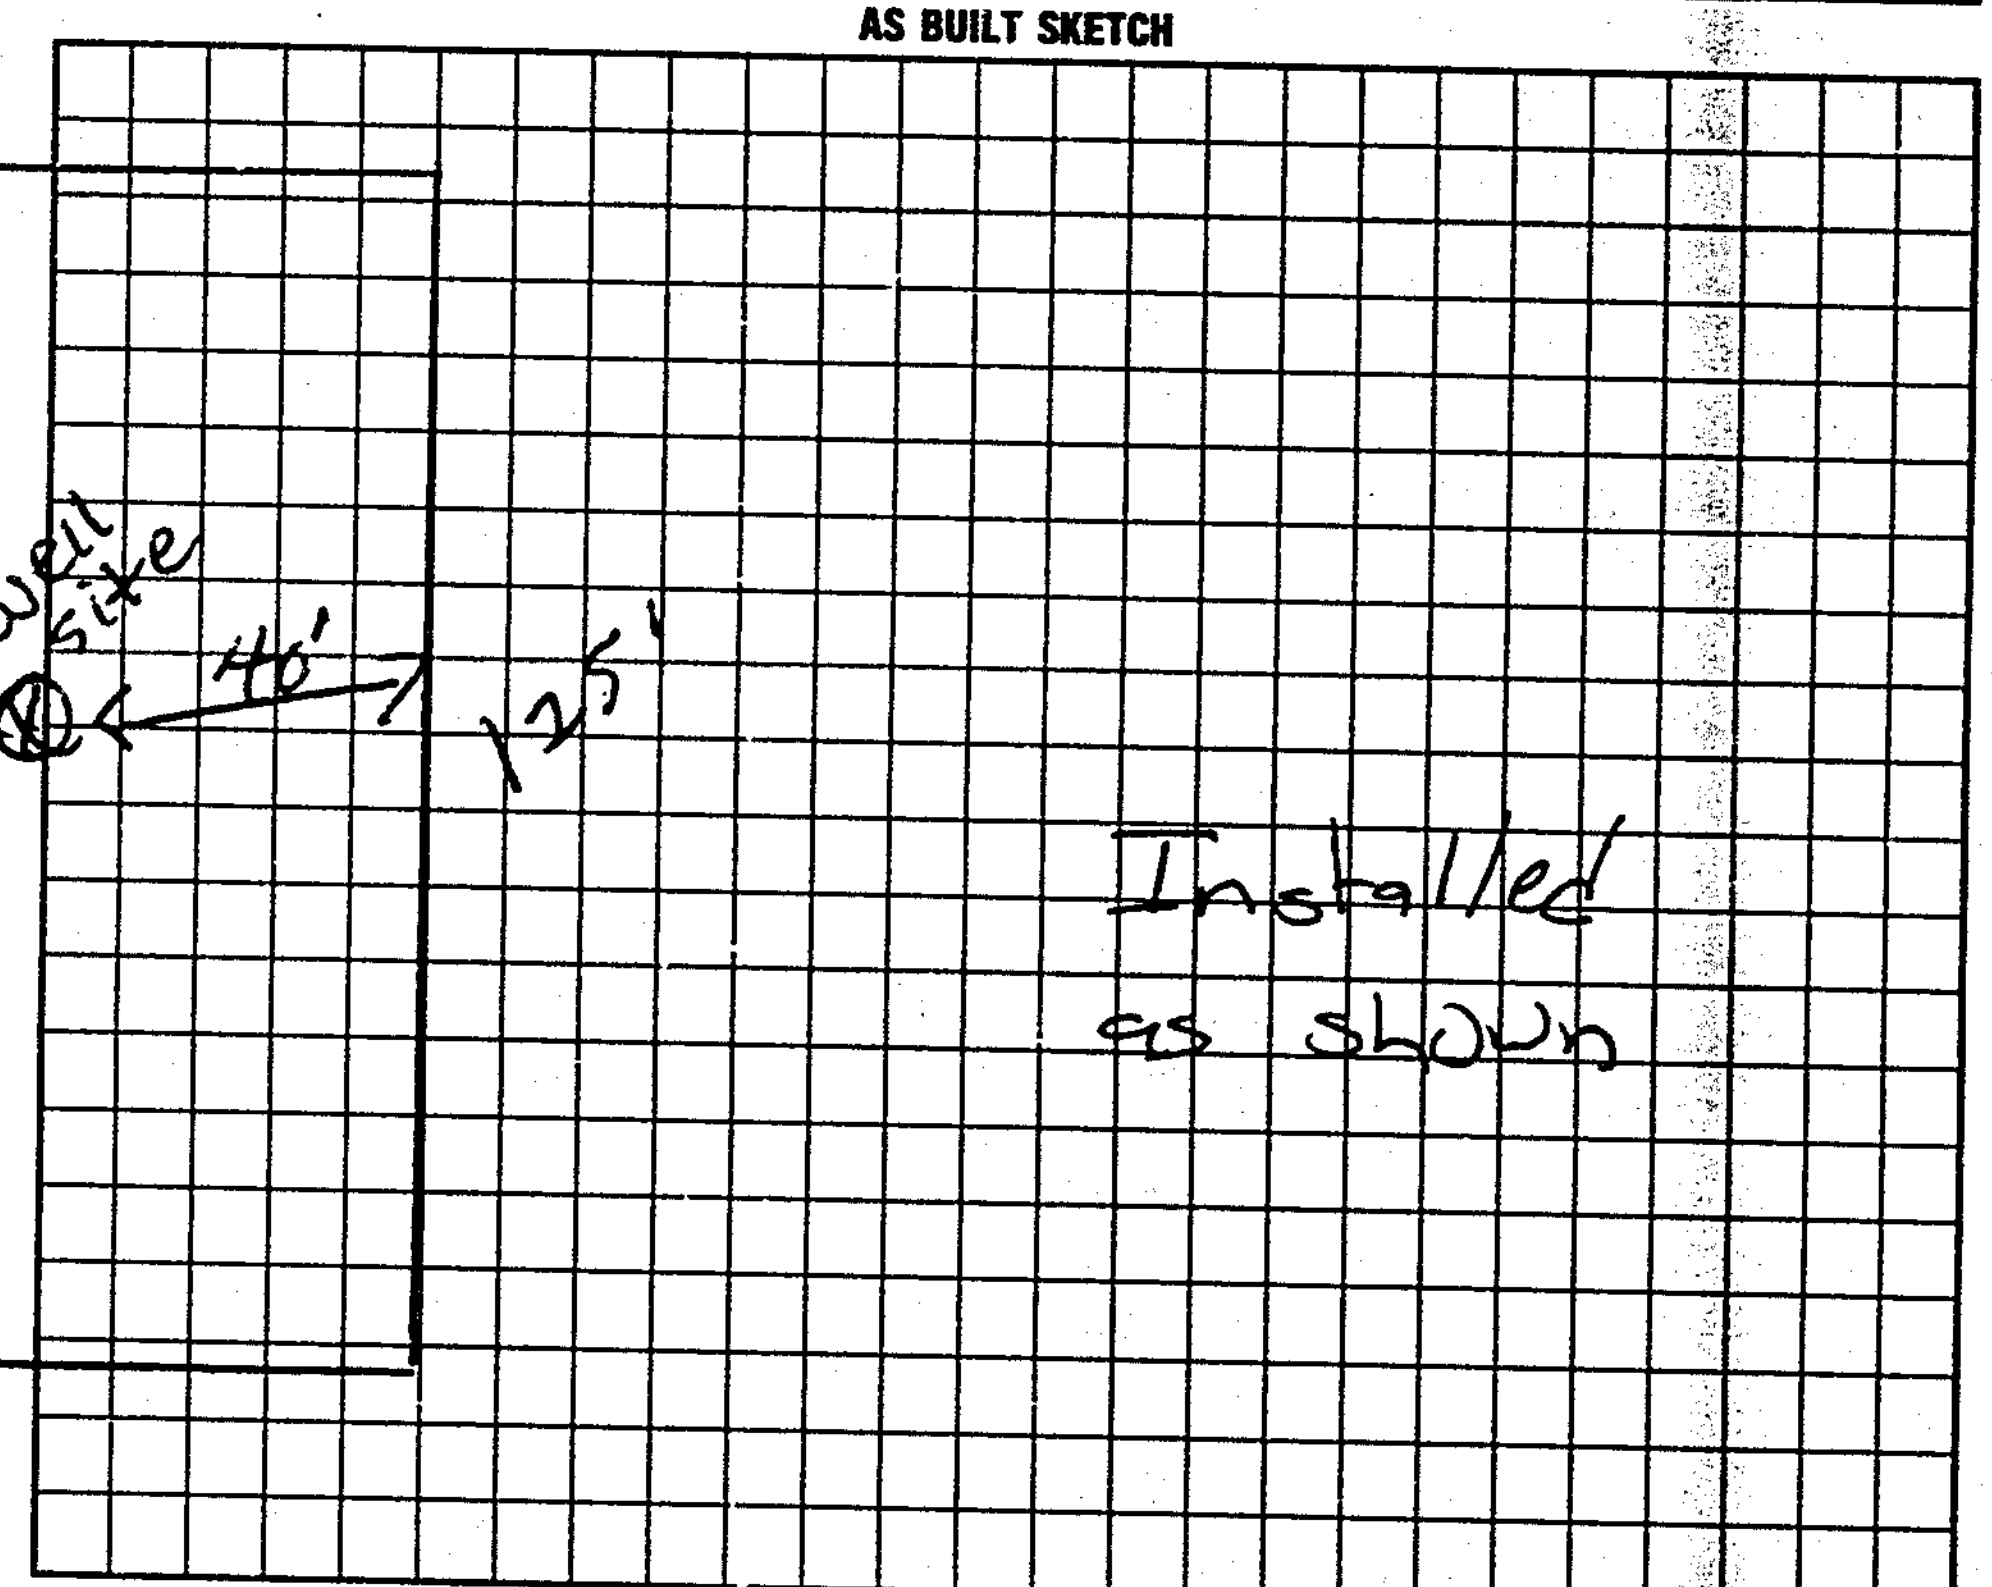

I understand that this permit can be suspended or revoked if any false information is supplied toward securing the permit/any unauthorized changes are made to the site/any unauthorized changes are made in the installation of the system. Improvement Permit is valid for 60 months from date of issuance.

Signed: D B Shuttlesworth

Installed by: C & W Grading & Septic

Improvement Permit by: R.C. Moore date 12-17-96

Certificate of Completion by: date

Existing System Inspection by: authorization to const R.C. Moore date 12-17-96

Operation Permit by: Mark C. ? RS date 8-5-98

HEALTH DEPT. COPY: WHITE INSPECTION COPY (FINAL): GREEN OWNER COPY (FINAL): YELLOW INSPECTION COPY (INITIAL): PINK OWNER COPY (INITIAL): GOLD

Authorization to const. Expires 60mos from issue