IREDELL COUNTY HEALTH DEPARTMENT

Statesville Office (704) 878-5305 Mooresville Office (704) 660-3625 PERMIT # 224452

IMPROVEMENT PERMIT / AUTHORIZATION TO CONSTRUCT / OPERATION PERMIT / EXISTING SYSTEM

PIN # 3796-31-3730

APPLICANT: DAVID MCNEELY APPLICANT ADDRESS: 358 LINDSEY FARM RD.-STONEY POINT

SITE ADDRESS: SAME PHONE: 704-928-7570 ALT. PHONE:


SITE DIRECTIONS: OLD MOUNTAIN RD, TR LINDSEY FARM, 3RD ON L

SUBDIVISION: — SECTION: — LOT # — LOT AREA: 5.25AC DESIGN FLOW: 360 L.T.A.R.: .3


Septic Tank 1000 (gal)	STB 160	Date 11-15-16	☐ New System ☒ Repair ☐ Expansion	System Type: I II (III) IV V VI	☒ Residence	No. Bedrooms 3	Water Supply
Pump Tank (gal)	PT	Date	System Description:		☐ Business	No. Persons 6	☐ Private
Pump Make	Model	Serial #	Repair System Description: 25% REDUCTION		☐ Other	No. Employees	☒ Public
# Nitrification Fields	# Lines 4@75'	Linear Ft: 300'	Maintenance Agreement Required: ☐ YES ☒ NO		☐ Slab	☒ Crawl Space	☐ Community
Trench Width 36"	(Max) Trench Bottom Depth 30"	Gravel Depth —	☒ GRAVITY ☐ PRESSURE		☐ Basement w/plumbing	☐ Basement w/o plumbing	

Comments / Conditions: RECOMMEND PUMP, CRUSH & FILL OLD TANK
OLD TANK POSSIBLY ON NEIGHBORS PROPERTY

INITIAL SITE SKETCH

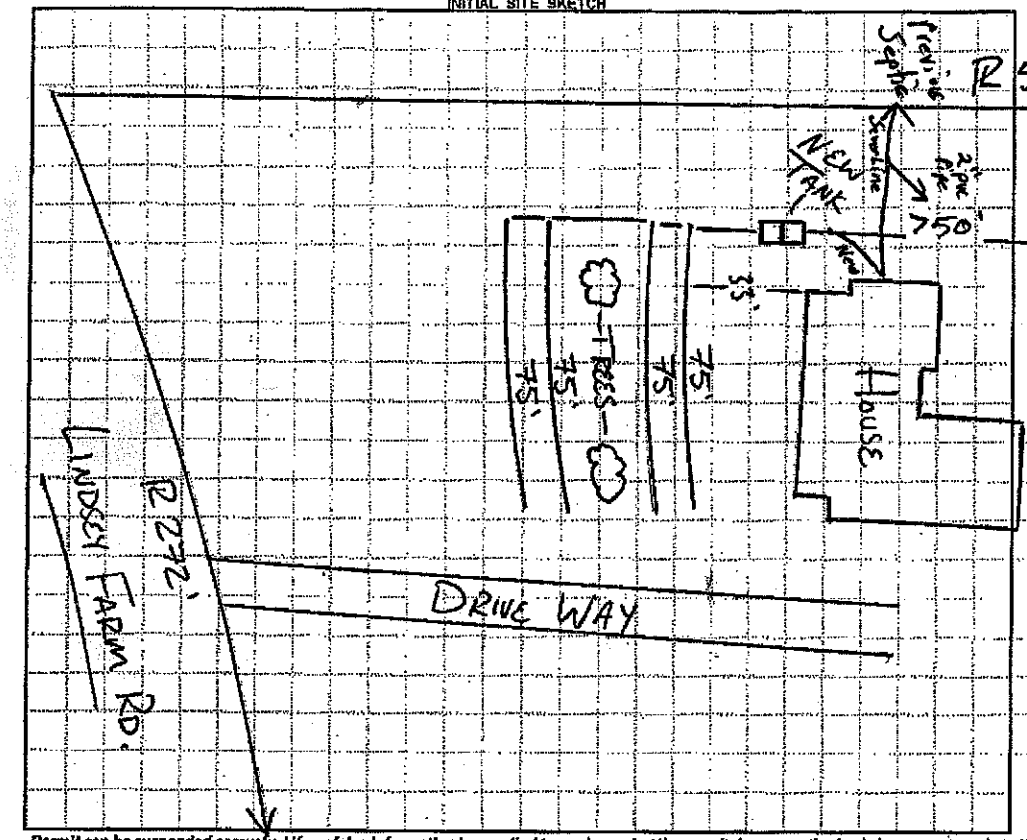

AS BUILT SKETCH

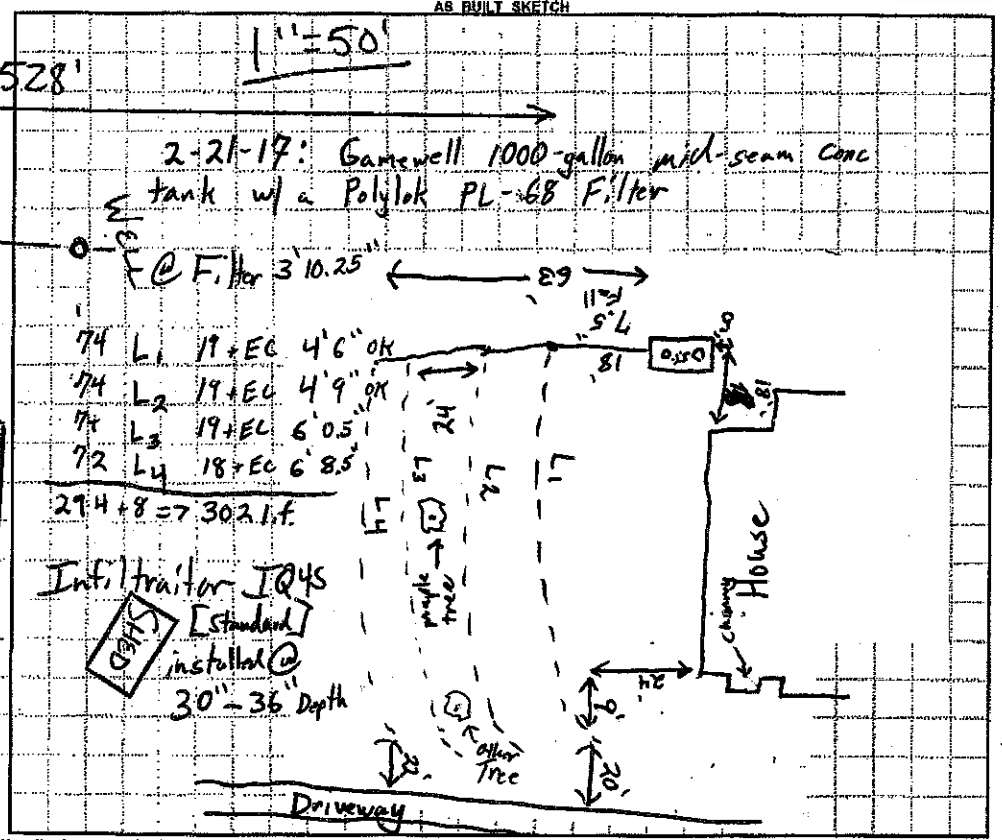

Permit can be suspended or revoked if any false information is supplied toward securing the permit / any unauthorized changes are made to the site / any unauthorized changes are made in the installation of the system. **CONTACT A LOCATOR SERVICE PRIOR TO ANY EXCAVATION**

☐ **IMPROVEMENT PERMIT** *with plat valid without expiration.* ☒ **IMPROVEMENT PERMIT** *with site plan valid for 60 mos.* ☒ **AUTHORIZATION TO CONSTRUCT** *valid for period equal to IMPROVEMENT PERMIT--not to exceed 60 mo.*

Owner / Applicant Signature: Mary McNeely Date: 2-13-17 Installed by: Steven Cothren #1838

IMPROVEMENT PERMIT by: [signature] Date: 2-13-17 OPERATION PERMIT by: Tom Shuck Date: 2-21-17

AUTHORIZATION TO CONSTRUCT by: [signature] Date: 2-13-17 Existing System Inspected by: Date: