3:30-3:45 @ Jeane Kirkpatrick

IREDELL COUNTY HEALTH DEPARTMENT

STATESVILLE 704-878-5305 MOORESVILLE 704-664-5281

IMPROVEMENT PERMIT / CERTIFICATE OF COMPLETION / OPERATION PERMIT / EXISTING SYSTEM INSPECTION

PROPERTY DESCRIPTION NO. 23426 DATE 4-20-96 TAX MAP NO. 8614 A 75 Watershed: ☐ Yes ☐ No

OWNER OR CONTRACTOR Clyde Itall Enterprises PHONE: Business 664 6400 Home

ADDRESS PO Box 1556 Mooresville N.C.

LOCATION Old Mtn Rd TR Finley Farm Rd 1/2 mi Rt

SUBDIVISION Lindsey Farms BLOCK / SECTION LOT LOT AREA 11 Acres SITE CLASS. PS DESIGN FLOW 360 L.T.A.R. .25

Septic Tank: 1000 Gallons; STB 825 Rowan Date 2/20/97

Pump Tank: Gallons; PT Date

Pump Make: Model 1HP40 Serial No. 4870

Nitrification Field: No Fields 1 Square Feet 4000 Linear Feet 1440

No Lines 6 Trench Width 36" Max Trench Bottom Depth 36" Gravel Depth 12"

☑ New System ☐ Repair System Type: I, II, III, IV, V, VI

System Description: Conv. Gravity

Repair System Description: Gravity chambers

Maintenance Agreement Required: ☐ Yes ☐ No

☐ House/Mod. Home ☑ Mobile Home ☐ Business ☐ Other

No. Bedrooms 3 No. Bathrooms 2 No. Employees


☐ Slab ☐ Crawl Space ☐ Basement w/plumbing ☐ Basement wo/plumbing

Water Supply: ☑ Individual ☐ Community ☐ Public


Comments: Keep well 100' from S.T. System

Comments:

INITIAL SITE SKETCH

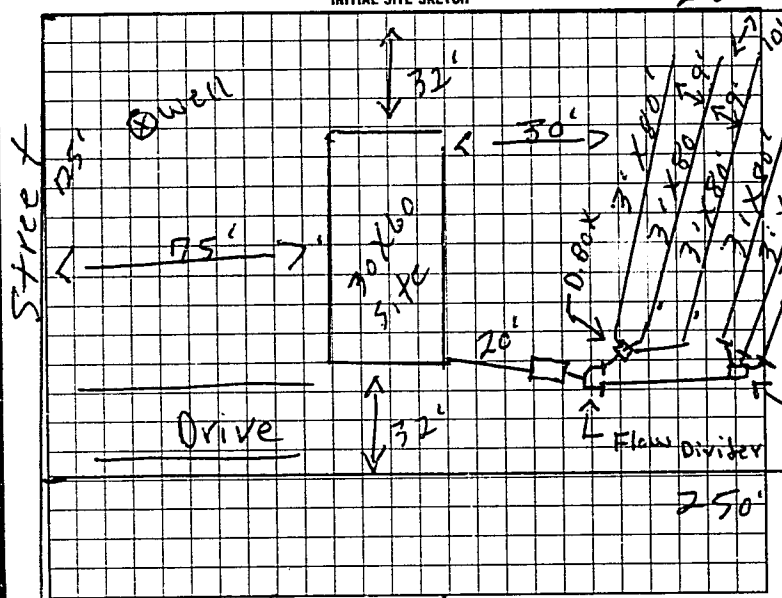

AS BUILT SKETCH

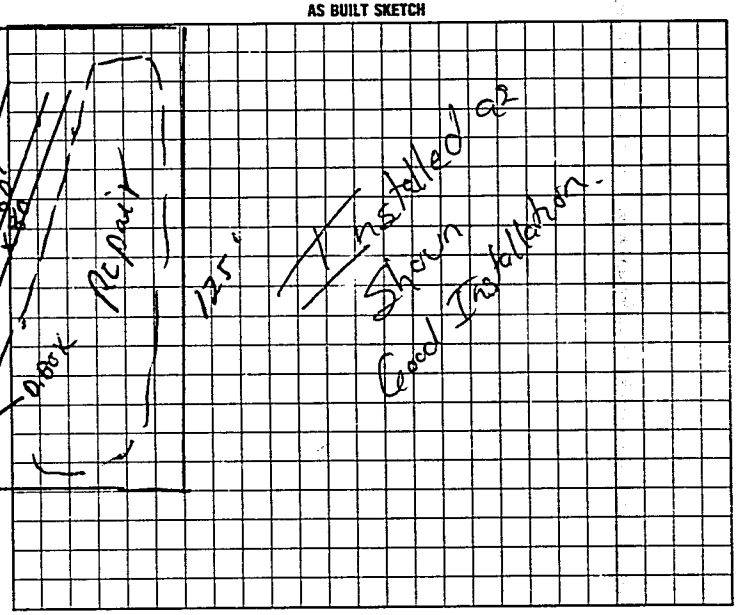

I understand that this permit can be suspended or revoked if any false information is supplied toward securing the permit/any unauthorized changes are made to the site/any unauthorized changes are made in the installation of the system.

Signed: David Stinchcomb Installed by: Rowan Septic Tank

Improvement Permit by: P.C. moore date 4-20-96 Certificate of Completion by: date

Existing System Inspection by: P.C. moore date 4-20-96 Operation Permit by: date 4/21/97

Authorization to Const.

HEALTH DEPT. COPY: WHITE INSPECTION COPY (FINAL): GREEN OWNER COPY (FINAL): YELLOW INSPECTION COPY (INITIAL): PINK OWNER COPY (INITIAL): GOLD

Authorization to Const. Expires 60 mos from issue

S 8 8 0 0 0