IREDELL COUNTY HEALTH DEPARTMENT

STATESVILLE 704-878-5305 MOORESVILLE 704-664-5281

IMPROVEMENT PERMIT / CERTIFICATE OF COMPLETION / OPERATION PERMIT / EXISTING SYSTEM INSPECTION

PROPERTY DESCRIPTION NO. 23427 DATE 4-20-96 TAX MAP NO. 8U A75 Watershed: ☐ Yes ☐ No

OWNER OR CONTRACTOR Clyde Hall Enterprizes PHONE: Business 664 6400 Home

ADDRESS Po Box 1556 Mooresville N.C.

LOCATION 01 f mtn Rd W TR Lindsey Fm Rd 1/2 mi Rt

SUBDIVISION Lindsey Fm acres BLOCK / SECTION ______ LOT 3 LOT AREA .717 acres SITE CLASS. PS DESIGN FLOW 360 L.T.A.R. .25

Septic Tank: 1000 Gallons: STB 825 Date 12-20-96

Pump Tank: ______ Gallons: PT ______ Date ______

Pump Make: ______ Model ______ Serial No. ______

Nitrification Field: No Fields 1 Square Feet 1440 Linear Feet 480

No Lines 6 Trench Width 36" Max Trench Bottom Depth 36" Gravel Depth 12"

☑ New System ☐ Repair System Type: I, II, III, IV, V, VI

System Description: Conv. Gravity

Repair System Description: Gravity chambers

Maintenance Agreement Required: ☐ Yes ☑ No

☐ House/Mod. Home ☑ Mobile Home ☐ Business ☐ Other

No. Bedrooms 3 No. Bathrooms 2 No. Employees ______


☐ Slab ☑ Crawl Space ☐ Basement w/plumbing ☐ Basement wo/plumbing

Water Supply: ☑ Individual ☐ Community ☐ Public


Comments: Keep well 100' from S.T. system

Comments: wells not install at time of inspection

INITIAL SITE SKETCH

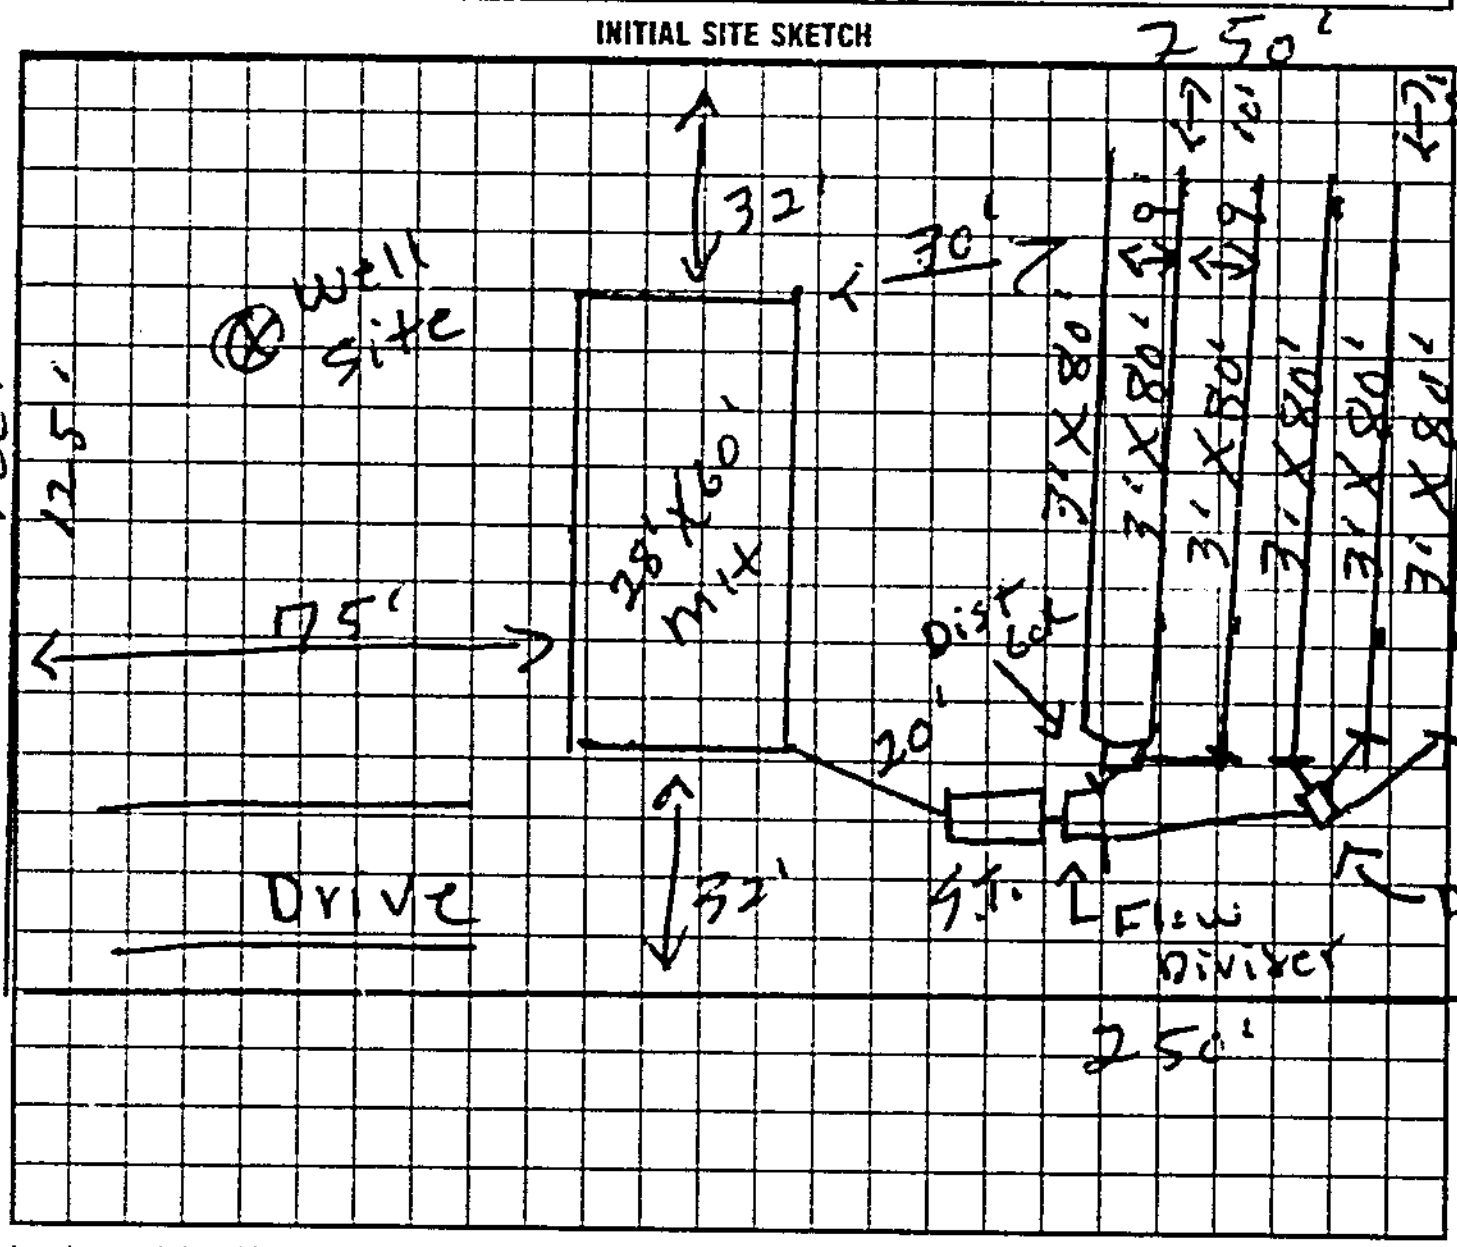

AS BUILT SKETCH

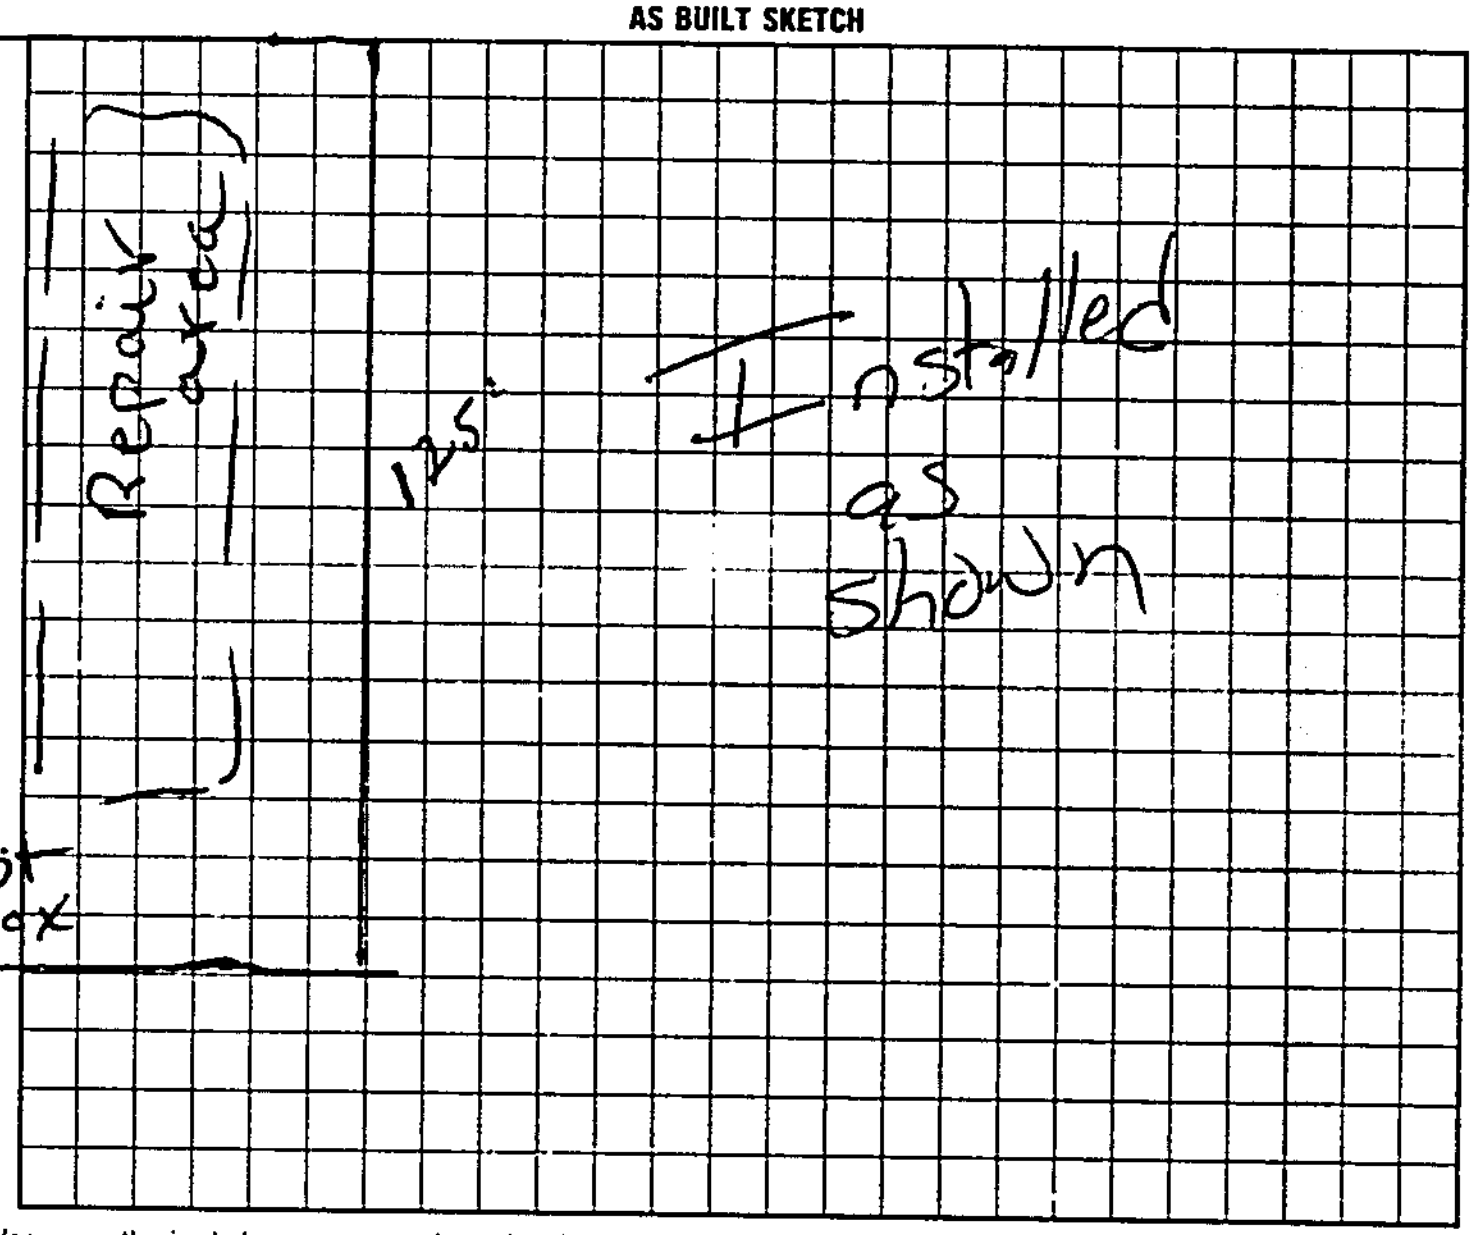

I understand that this permit can be suspended or revoked if any false information is supplied toward securing the permit/any unauthorized changes are made to the site/any unauthorized changes are made in the installation of the system.

Authorization to Construct is valid five (5) years from date of issuance. Improvement Permit has no expiration date.

Signed: [signature]

Installed by: Rowan Septic

Improvement Permit by: C. Moore date 4-20-96

Certificate of Completion by: ______ date ______

Existing System Inspection by: ______

AUTHORIZATION TO CONSTRUCT: C. Moore date 4-20-96

Operation Permit by: [signature] RS date 3-21-97

HEALTH DEPT. COPY: WHITE INSPECTION COPY (FINAL): GREEN OWNER COPY (FINAL): YELLOW INSPECTION COPY (INITIAL): PINK OWNER COPY (INITIAL): GOLD

667000