IREDELL COUNTY HEALTH DEPARTMENT

STATESVILLE 704-878-5305 MOORESVILLE 704-664-5281

IMPROVEMENT PERMIT / CERTIFICATE OF COMPLETION / OPERATION PERMIT / EXISTING SYSTEM INSPECTION

PROPERTY DESCRIPTION NO. 25173 DATE 12-7-96 TAX MAP NO. Pt 84-A-76 Watershed: ☐ Yes ☑ No

OWNER OR CONTRACTOR Clyde Hall PHONE: Business 585-2728 Home

ADDRESS PO Box 1556 Mooresville

LOCATION Old Mtn Rd TR Lindsey Fm Rd TR Barley Ln TR millet 1st lot Rt

SUBDIVISION Lindsey Fm BLOCK / SECTION LOT 22 LOT AREA .717 acres SITE CLASS. PS DESIGN FLOW 360 L.T.A.R. .3

Septic Tank: 1000 Gallons; STB 1012 Date 11-12-97

Pump Tank: Gallons; PT Date

Pump Make: Model Serial No.

Nitrification Field: No Fields 1 Square Feet 1200 Linear Feet 400

No Lines 4 Trench Width 36" Max Trench Bottom Depth 36" Gravel Depth 12"

☐ New System ☐ Repair System Type: I, ☑ II, III, IV, V, VI

System Description: Conv. Gravity

Repair System Description: Gravity Chambers

Maintenance Agreement Required: ☐ Yes ☑ No

☐ House/Mod. Home No. Bedrooms 3

☑ Mobile Home No. Bathrooms 2

☐ Business No. Employees

☐ Other


☐ Slab ☑ Crawl Space ☐ Basement w/plumbing ☐ Basement wo/plumbing

Water Supply: ☑ Individual ☐ Community ☐ Public

Comments:

Comments:

INITIAL SITE SKETCH

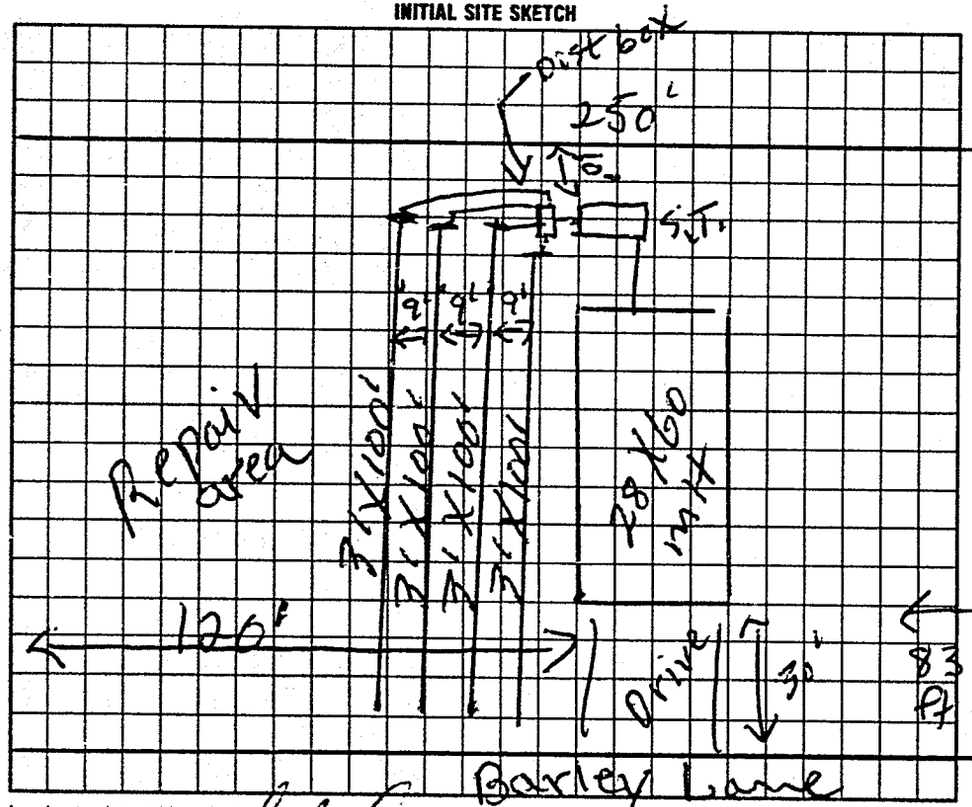

AS BUILT SKETCH

millet Street - 125'

I understand that this permit can be suspended or revoked if any false information is supplied toward securing the permit/any unauthorized changes are made to the site/any unauthorized changes are made in the installation of the system. Improvement Permit is valid for 60 months from date of issuance.

Signed: D B Shuford

Improvement Permit by: R.C. Moore date 12-7-96

Authorization ~~Existing System Inspection~~ by: R.C. Moore date 12-7-96

to cover

Installed by: Kenny Madison

Certificate of Completion by: date

Operation Permit by: Mary C Davis date 2-26-98

HEALTH DEPT. COPY: WHITE INSPECTION COPY (FINAL): GREEN OWNER COPY (FINAL): YELLOW INSPECTION COPY (INITIAL): PINK OWNER COPY (INITIAL): GOLD

authorization to cover EXPIRES 60 mos from issue