IREDELL COUNTY HEALTH DEPARTMENT

STATESVILLE 704-878-5305 MOORESVILLE 704-664-5281

IMPROVEMENT PERMIT / CERTIFICATE OF COMPLETION / OPERATION PERMIT / EXISTING SYSTEM INSPECTION

PROPERTY DESCRIPTION NO. 25183 77347 DATE 12-7-96 TAX MAP NO. Pt 8U - A - 76 Watershed: ☐ Yes ☒ No

OWNER OR CONTRACTOR Clyde Itall PHONE: Business 585 2728 Home

ADDRESS PO Box 1556 Mooresville

LOCATION Off nth Rt TR Lindsey Fm Rt TR Barley Ln TR Millet 1st lot Rt

SUBDIVISION Lindsey Fm BLOCK / SECTION LOT 32 LOT AREA 1.43 acres SITE CLASS. PS DESIGN FLOW 360 L.T.A.R. 1.25

Septic Tank: 1000 Gallons; STB 1012 Date 8-3-98

Pump Tank: Gallons; PT Date

Pump Make: Model Serial No.

Nitrification Field: No Fields 1 Square Feet 1440 Linear Feet 480

No Lines 4 Trench Width 36" Max Trench Bottom Depth 34" Gravel Depth 12"

☐ New System ☐ Repair System Type: I, II, III, IV, V, VI

System Description: Conv. Gravity

Repair System Description: Gravity/Chambers

Maintenance Agreement Required: ☐ Yes ☒ No

☐ House/Mod. Home ☒ Mobile Home ☐ Business ☐ Other

No. Bedrooms 3 No. Bathrooms 2 No. Employees


☐ Slab ☒ Crawl Space ☐ Basement w/plumbing ☐ Basement wo/plumbing

Water Supply: ☒ Individual ☐ Community ☐ Public


Comments: Keep lines shallow 24" maximum

Comments:

INITIAL SITE SKETCH

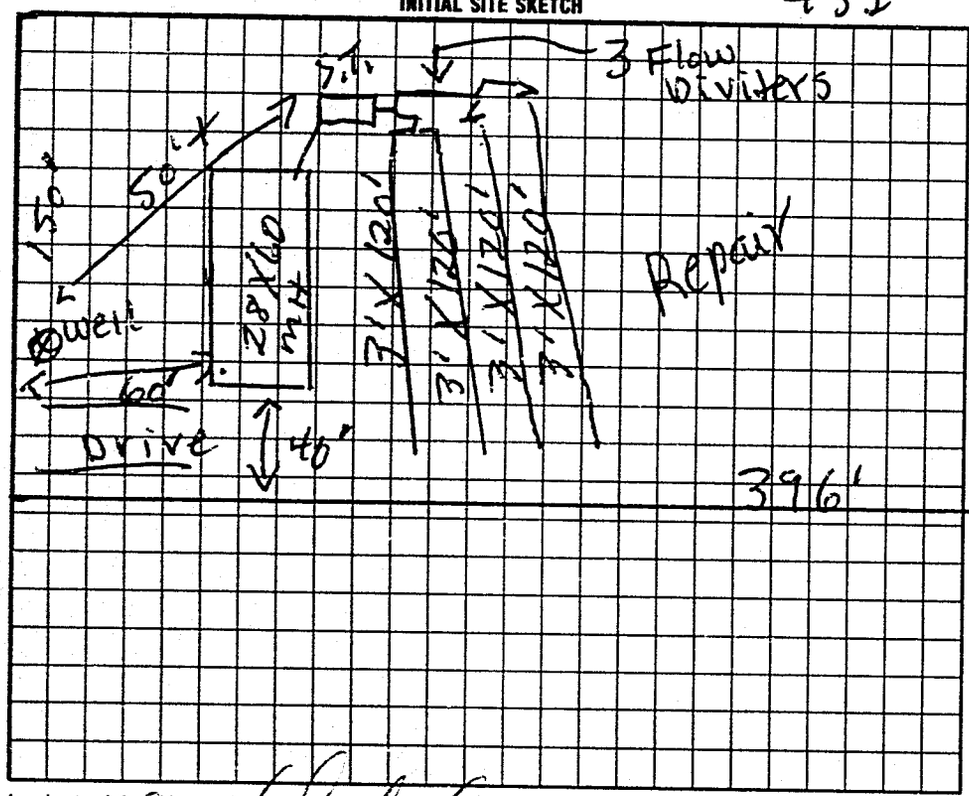

AS BUILT SKETCH

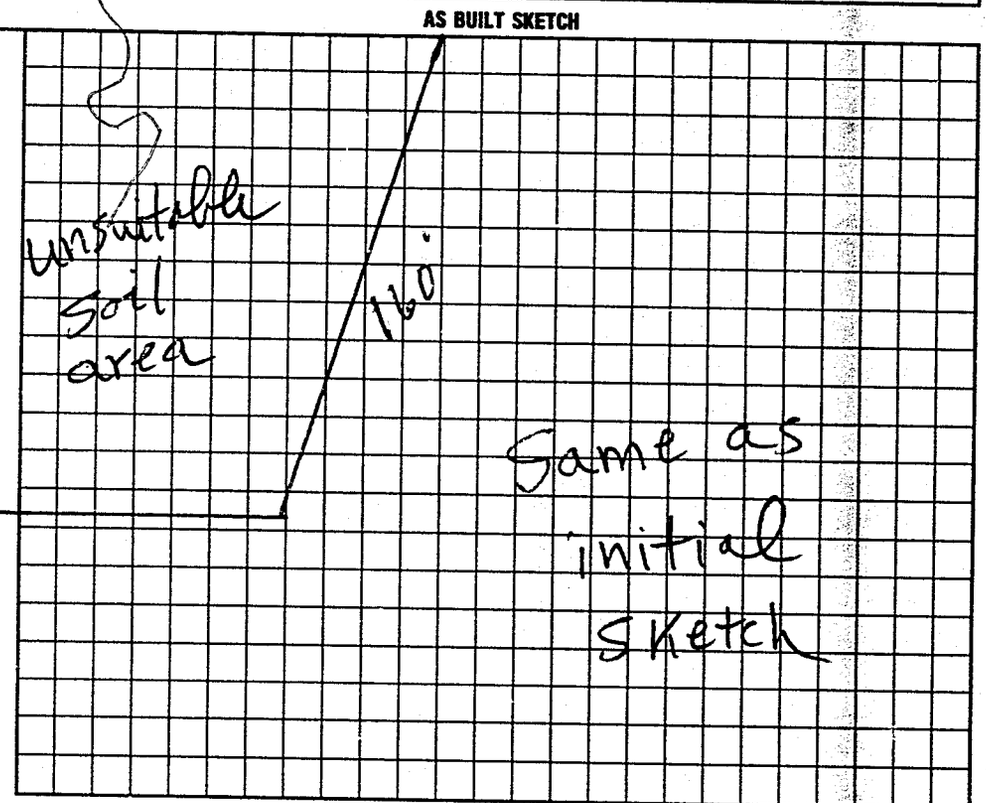

I understand that this permit can be suspended or revoked if any false information is supplied toward securing the permit/any unauthorized changes are made to the site/any unauthorized changes are made in the installation of the system. Improvement Permit is valid for 60 months from date of issuance.

Signed:

Improvement Permit by: P. C. Moore date 12-7-96

Existing System Inspection by: P. C. Moore date 12-7-96

Installed by: Kenny Madison

Certificate of Completion by: date

Operation Permit by: P. C. Moore date 10-2-98

HEALTH DEPT. COPY: WHITE INSPECTION COPY (FINAL): GREEN OWNER COPY (FINAL): YELLOW INSPECTION COPY (INITIAL): PINK OWNER COPY (INITIAL): GOLD

authorization to cover. Authorization to cover EXPIRES 6 months from issue