IREDELL COUNTY HEALTH DEPARTMENT

STATESVILLE 704-878-5305 MOORESVILLE 704-664-5281

IMPROVEMENT PERMIT / CERTIFICATE OF COMPLETION / OPERATION PERMIT / EXISTING SYSTEM INSPECTION

PROPERTY DESCRIPTION NO. 25185 DATE 12-7-96 TAX MAP NO. pt 84-A-76 Watershed: ☐ Yes ☐ No

OWNER OR CONTRACTOR Clyde Hall PHONE: Business 585-2728 Home

ADDRESS PO Box 1556 Mooresville, N.C.

LOCATION old mtn Rd TR Lintsey Fm Rd TR Barkley Ln TL millet 3rd lot Rt

SUBDIVISION Lintsey Fm BLOCK / SECTION LOT 34 LOT AREA 1.56 acres SITE CLASS. PS DESIGN FLOW 360 L.T.A.R. .25

Septic Tank: 1000 Gallons; STB 1012 Date 3-14-97

Pump Tank: Gallons; PT Date

Pump Make: Model Serial No.

Nitrification Field: No Fields 1 Square Feet 1440 Linear Feet 480

No Lines 4 Trench Width 36" Max Trench Bottom Depth 24" Gravel Depth 12"

☑ New System ☐ Repair System Type: I, II, III, IV, V, VI

System Description: Conv. Gravity

Repair System Description: Gravity Chambers

Maintenance Agreement Required: ☐ Yes ☑ No

☐ House/Mod. Home ☑ Mobile Home ☐ Business ☐ Other

No. Bedrooms 3 No. Bathrooms 2 No. Employees

☐ Slab ☑ Crawl Space ☐ Basement w/plumbing ☐ Basement wo/plumbing

Water Supply: ☑ Individual ☐ Community ☐ Public


Comments:

24" maximum Trench Depth


Comments:

Tank & drive Removed from initial sketch

INITIAL SITE SKETCH

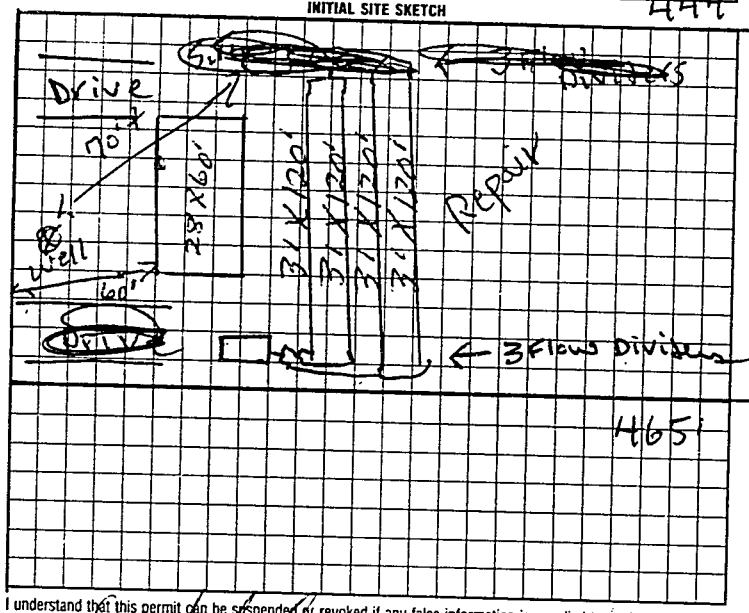

AS BUILT SKETCH

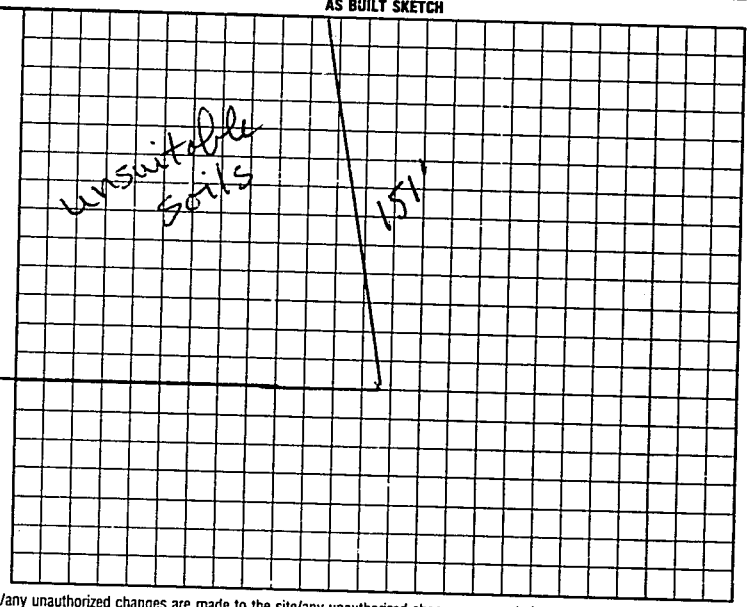

I understand that this permit can be suspended or revoked if any false information is supplied toward securing the permit/any unauthorized changes are made to the site/any unauthorized changes are made in the installation of the system. Improvement Permit is valid for 60 months from date of issuance.

Signed:

Improvement Permit by: P.C. Moore date 12-17-96

Existing System Inspection by: P.C. Moore date 12-7-96

Authorization to cover

Installed by: Kenny Madison

Certificate of Completion by: date

Operation Permit by: P.C. Moore date 7-15-97

HEALTH DEPT. COPY WHITE INSPECTION COPY (FINAL) GREEN OWNER COPY (FINAL) YELLOW INSPECTION COPY (INITIAL) PINK OWNER COPY (INITIAL) GOLD

authorization to cover Expires 60 mos from issue