IREDELL COUNTY HEALTH DEPARTMENT

STATESVILLE 704-878-5305 MOORESVILLE 704-664-5281

IMPROVEMENT PERMIT / CERTIFICATE OF COMPLETION / OPERATION PERMIT / EXISTING SYSTEM INSPECTION

PROPERTY DESCRIPTION NO. 25469 C67136 DATE 12-7-96 TAX MAP NO. Pt 84-A-76 Watershed: ☐ Yes ☑ No

OWNER OR CONTRACTOR Clyde Hall PHONE: Business 585-2728 Home

ADDRESS P.C. Box 1556 Mooresville

LOCATION Old Mtn Rd TR Lindsey Em Rd TR Barkley Ln TL Millet 4th lot left

SUBDIVISION Lindsey Em BLOCK / SECTION LOT 18 LOT AREA .803 SITE CLASS. PS DESIGN FLOW 360 L.T.A.R. .3

Septic Tank: 1000 Gallons; STB 525 Date 12-19-97

Pump Tank: Gallons; PT Date

Pump Make: Model Serial No.

Nitrification Field: No Fields 1 Square Feet 900 Linear Feet 300

No Lines 3 Trench Width 36" Max Trench Bottom Depth 36" Gravel Depth N/A

☑ New System ☐ Repair System Type: I, II, III, IV, V, VI

System Description: Gravity Chambers

Repair System Description: " "

Maintenance Agreement Required: ☐ Yes ☑ No

☐ House/Mod. Home No. Bedrooms 3

☑ Mobile Home No. Bathrooms 2

☐ Business No. Employees

☐ Other


☐ Slab ☑ Crawl Space ☐ Basement w/plumbing ☐ Basement wo/plumbing

Water Supply: ☑ Individual ☐ Community ☐ Public


Comments:

Comments:

INITIAL SITE SKETCH

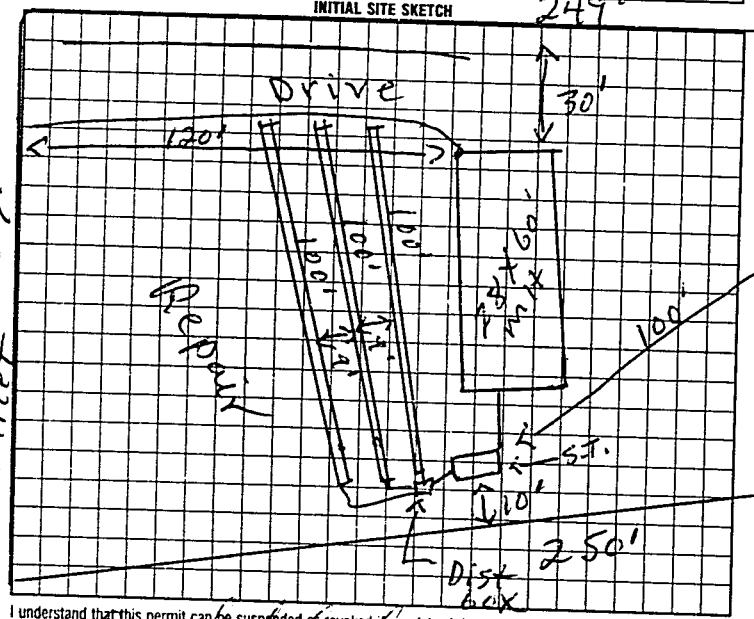

AS BUILT SKETCH

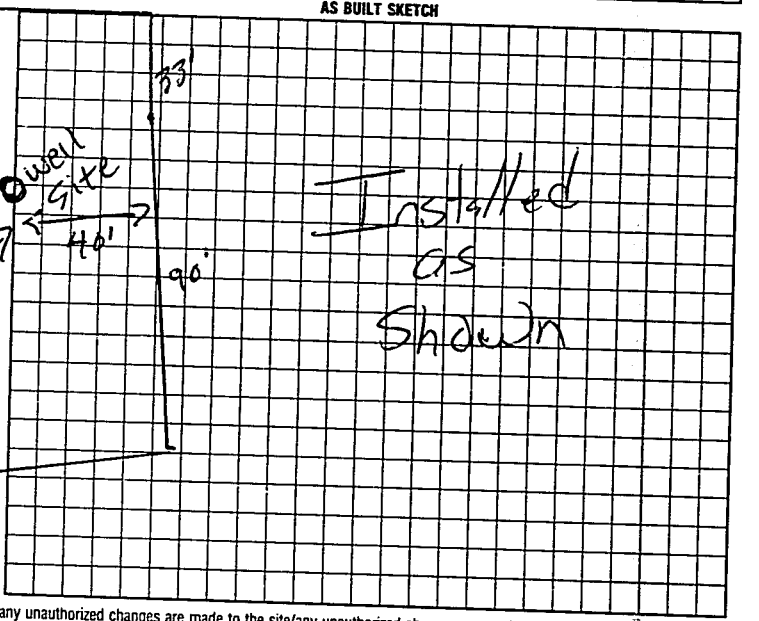

I understand that this permit can be suspended or revoked if any false information is supplied toward securing the permit/any unauthorized changes are made to the site/any unauthorized changes are made in the installation of the system. Improvement Permit is valid for 60 months from date of issuance.

Signed:

Improvement Permit by: E.C. Moore date 12-7-96

Authorization to Existing System Inspection by: E.C. Moore date 12-7-96

Authorization to count Expires 60 mos from issue

Installed by: Rowan Septic

Certificate of Completion by: date

Operation Permit by: Mary C Cutts RS date 6-26-97

HEALTH DEPT. COPY: WHITE INSPECTION COPY (FINAL): GREEN OWNER COPY (FINAL): YELLOW INSPECTION COPY (INITIAL): PINK OWNER COPY (INITIAL): GOLD