IREDELL COUNTY HEALTH DEPARTMENT

STATESVILLE 704-878-5305 MOORESVILLE 704-664-5281

IMPROVEMENT PERMIT / CERTIFICATE OF COMPLETION / OPERATION PERMIT / EXISTING SYSTEM INSPECTION

PROPERTY DESCRIPTION NO. 2518-06-7411 DATE 12-7-96 TAX MAP NO. Pt 8 Li - A-76 Watershed: ☐ Yes ☑ No

OWNER OR CONTRACTOR Clyde Hall PHONE: Business 585-2228 Home

ADDRESS Po Box 1556 Mooresville, N.C.

LOCATION Pt Mtn Rd TR Lintsey Fm Rd TR Barkley Ln TL Millet Dr. 4th lot Rt.

SUBDIVISION Lintsey Fm BLOCK / SECTION LOT 35 LOT AREA 1.15 acres SITE CLASS. PSI DESIGN FLOW 360 L.T.A.R. 1.25

Septic Tank: 1000 Gallons; STB 825 Date 4-11-97

Pump Tank: Gallons; PT Date

Pump Make: Model Serial No.

Nitrification Field: No Fields 1 Square Feet 1440 Linear Feet 480

No Lines 4 Trench Width 36 Max Trench Bottom Depth 24" Gravel Depth 12"

☐ New System ☐ Repair System Type: I, II, III, IV, V, VI

System Description: Conv. Gravity

Repair System Description: Gravity Chambers

Maintenance Agreement Required: ☐ Yes ☑ No

☐ House/Mod. Home ☑ Mobile Home ☐ Business ☐ Other

No. Bedrooms 3 No. Bathrooms 2 No. Employees


☐ Slab ☑ Crawl Space ☐ Basement w/plumbing ☐ Basement w/o plumbing

Water Supply: ☑ Individual ☐ Community ☐ Public


Comments:

Comments:

INITIAL SITE SKETCH

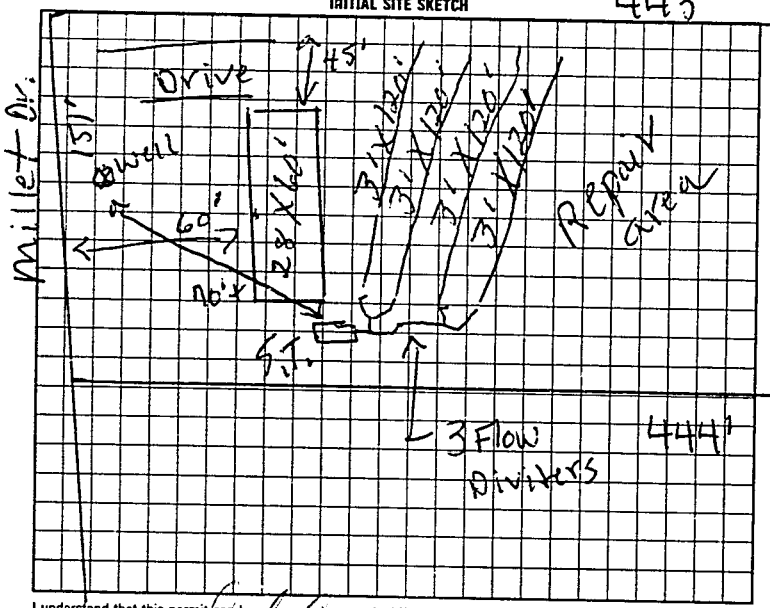

AS BUILT SKETCH

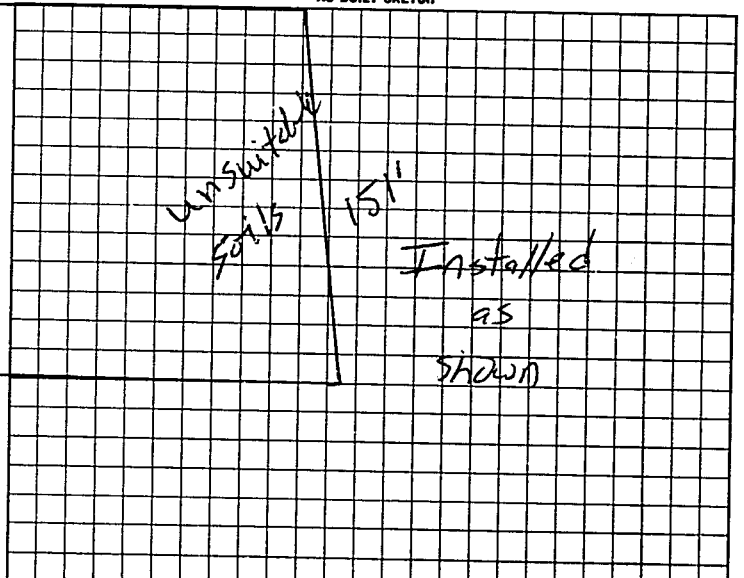

I understand that this permit can be suspended or revoked if any false information is supplied toward securing the permit/any unauthorized changes are made to the site/any unauthorized changes are made in the installation of the system. Improvement Permit is valid for 60 months from date of issuance.

Signed: [signature]

Improvement Permit by: L. C. Moore date 12-7-96

Authorization to Install System Inspection: L. C. Moore date 12-7-96

Installed by: Rowan Septic

Certificate of Completion by: date

Operation Permit by: Mary C. Ortiz date 7-9-97

Authorization to count Expires 60 days from issue

HEALTH DEPT COPY: WHITE INSPECTION COPY (FINAL): GREEN OWNER COPY (FINAL): YELLOW INSPECTION COPY (INITIAL): PINK OWNER COPY (INITIAL): GOLD

T58000