IREDELL COUNTY HEALTH DEPARTMENT

STATESVILLE 704-878-5305 #64584 3:00 MOORESVILLE 704-664-5281

IMPROVEMENT PERMIT / CERTIFICATE OF COMPLETION / OPERATION PERMIT / EXISTING SYSTEM INSPECTION

PROPERTY DESCRIPTION NO. 23429 DATE 4-20-96 TAX MAP NO. 8UA75 Watershed: ☐ Yes ☑ No

OWNER OR CONTRACTOR Clyde Hall Enterprizes PHONE: Business 664-6400 Home

ADDRESS PO Box 1556 Mooresville, N.C.

LOCATION 018 mtn rd west IR zinny Fm rd 1/2 mi rt

SUBDIVISION LINDSEY FARM ACRES BLOCK / SECTION I LOT 5 LOT AREA 0.77 ACRE SITE CLASS PS DESIGN FLOW 360 L.T.A.R. 0.25 GPD/FT²

Septic Tank: 1000 Gallons: STB 1012 Date 8-17-96
Pump Tank: ____ Gallons: PT ____ Date ____
Pump Make: ____ Model ____ Serial No. ____
Nitrification Field No. Fields 1 Square Feet 1440 Linear Feet 480
No. Lines 4 Trench Width 36" Max Trench Bottom Depth 36" Gravel Depth 12"

☑ New System ☐ Repair System Type: I, (II), III, IV, V, VI
System Description: conventional gravity
Repair System Description: Gravity Chambers
Maintenance Agreement Required: ☐ Yes ☑ No

☐ House/Mod. Home ☑ Mobile Home ☐ Business ☐ Other
No. Bedrooms 3 No. Bathrooms 2 No. Employees ____


☐ Slab ☑ Crawl Space ☐ Basement w/plumbing ☐ Basement wo/plumbing

Water Supply: ☑ Individual ☐ Community ☐ Public WELL


Comments: ① KEEP SYSTEM MINIMUM 100' FROM WELL ② USE THREE FLOW DIVIDER TEES TO ACHIEVE EQUAL DISTRIBUTION INTO FOUR 120' LINES

Comments:

INITIAL SITE SKETCH

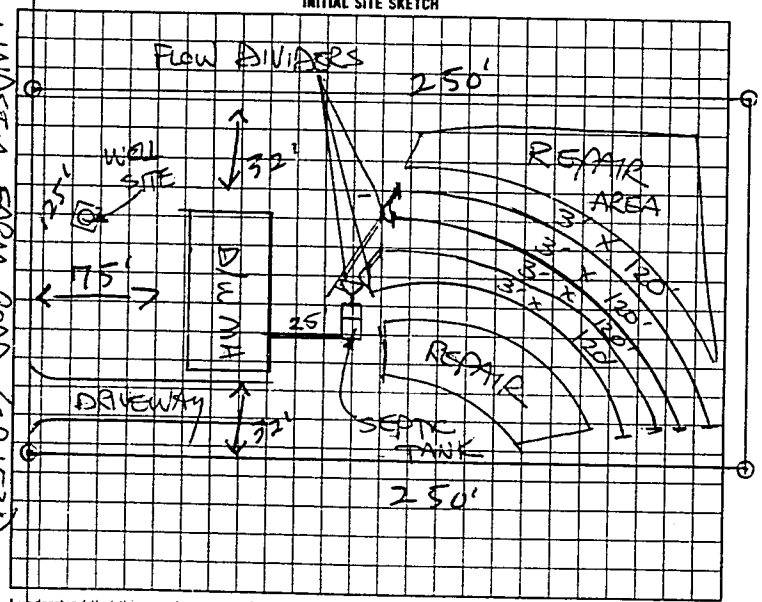

AS BUILT SKETCH

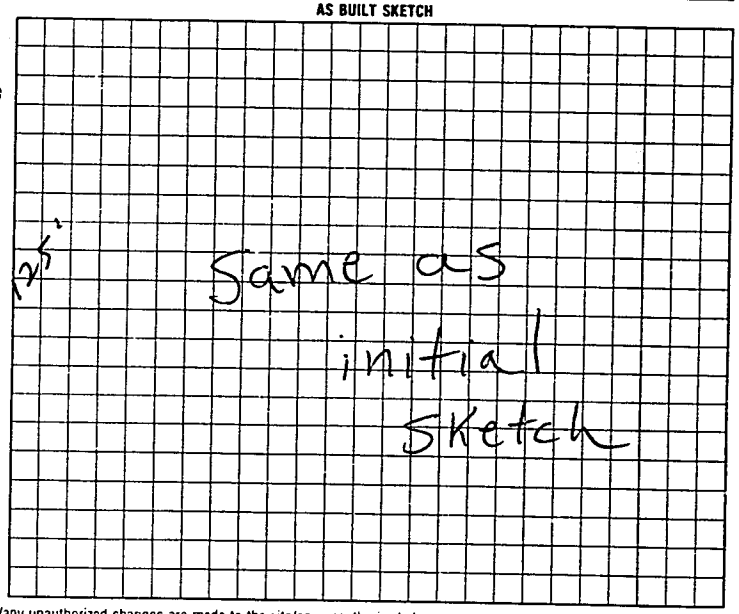

LINDSEY FARM ROAD (SR 1534)

I understand that this permit can be suspended or revoked if any false information is supplied toward securing the permit/any unauthorized changes are made to the site/any unauthorized changes are made in the installation of the system.

Signed: X David Stutts

Improvement Permit by: R.C. moore date 4-20-96

Authorization to Install System Inspection by: R.C. moore date 4-20-96

Installed by: Tommy Cothren

Certificate of Completion by: ____ date ____

Operation Permit by: R.C. moore date 12-23-96

to count

DEPT COPY WHITE INSPECTION COPY (FINAL) GREEN OWNER COPY (FINAL) YELLOW INSPECTION COPY (INITIAL) PINK OWNER COPY (INITIAL) GOLD

authorization to count EXPIRES 60 mos from issue

681000