H 64981 300cpm

IREDELL COUNTY HEALTH DEPARTMENT

STATESVILLE 704-878-5305 MOORESVILLE 704-664-5281

IMPROVEMENT PERMIT / CERTIFICATE OF COMPLETION / OPERATION PERMIT / EXISTING SYSTEM INSPECTION

PROPERTY DESCRIPTION NO. 23430 DATE 4-20-96 TAX MAP NO. 8U A N5 Watershed: ☐ Yes ☐ No

OWNER OR CONTRACTOR Clyde Hall Enterprises PHONE: Business 664-6400 Home

ADDRESS PO Box 1556 Mooresville N.C.

LOCATION old Mth Rd TR Lindsey Farm Rd 1/2 mi Rt

SUBDIVISION LINDSEY FARMS BLOCK / SECTION I LOT 6 LOT AREA 0.717 ACRE SITE CLASS PS DESIGN FLOW 360 L.T.A.R. 0.25 GPD/FT

Septic Tank: 1000 Gallons; STB 525 Date 10-11-96
Pump Tank: Gallons; PT Date
Pump Make: Model Serial No.
Nitrification Field: No Fields 1 Square Feet 1440 Linear Feet 480
No Lines 4 Trench Width 36" Max Trench Bottom Depth 18-36" Gravel Depth 12"

☑ New System ☐ Repair System Type: I. II. III. IV. V. VI
System Description: conventional gravity
Repair System Description: conventional pump
Maintenance Agreement Required: ☐ Yes ☐ No

☐ House/Mod. Home No. Bedrooms 3
☑ Mobile Home No. Bathrooms 2
☐ Business No. Employees
☐ Other


☐ Slab ☑ Crawl Space ☐ Basement w/plumbing ☐ Basement wo/plumbing

Water Supply:
☑ Individual
☐ Community
☐ Public
WELL

Comments:

Comments:

INITIAL SITE SKETCH

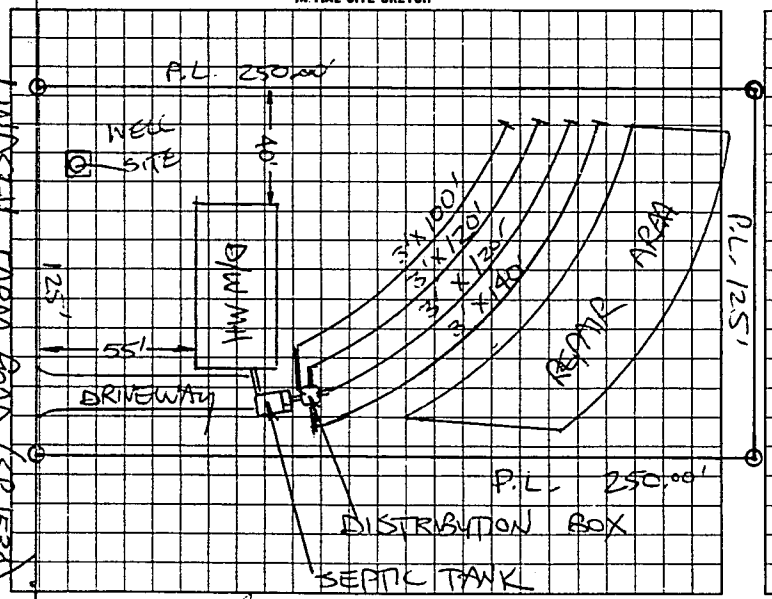

AS BUILT SKETCH

Installed as Shown

I understand that this permit can be suspended or revoked if any false information is supplied toward securing the permit/any unauthorized changes are made to the site/any unauthorized changes are made in the installation of the system.

Signed: David Strickland

Improvement Permit by: R.C. moore date 4-20-96

Existing System Inspection by: R.C. moore date 4-20-96

Installed by: Rowan Sept.C

Certificate of Completion by: date

Operation Permit by: Mark C Ozment RS date 1-27-97

to court

HEALTH DEPT. COPY: WHITE INSPECTION COPY (FINAL): GREEN OWNER COPY (FINAL): YELLOW INSPECTION COPY (INITIAL): PINK OWNER COPY (INITIAL): GOLD

authorization to court EXPIRES 60 DAYS from issue

7870000