IREDELL COUNTY HEALTH DEPARTMENT

STATESVILLE 704-878-5305 — MOORESVILLE 704-664-5281

63950

IMPROVEMENT PERMIT / CERTIFICATE OF COMPLETION / OPERATION PERMIT / EXISTING SYSTEM INSPECTION

PROPERTY DESCRIPTION NO. 23431 DATE 4-20-96 TAX MAP NO. 8614 A 175 Watershed: ☐ Yes ☐ No

OWNER OR CONTRACTOR Clyde Hall Enterprises PHONE: Business 664 6400 Home

ADDRESS PO Box 1556 Mooresville NC.

LOCATION Oakwood Rd W TR Linksey Fm Rd 1/2 mi Rt

SUBDIVISION LINDSEY FARM ACRES BLOCK / SECTION I LOT 7 LOT AREA 0.719 SITE CLASS PS DESIGN FLOW 360 L.T.A.R. 0.25 gpd/ft²

Septic Tank: 1000 Gallons; STB 825 Date 9-20-96

Pump Tank: ____ Gallons; PT ____ Date ____

Pump Make: ____ Model ____ Serial No. ____

Nitrification Field: No Fields 1 Square Feet 1440 Linear Feet 480

No Lines 5 Trench Width 36" Max Trench Bottom Depth 36" Gravel Depth 12"

☑ New System ☐ Repair System Type: I (II) III, IV, V, VI

System Description: CONVENTIONAL GRAVITY

Repair System Description: CONVENTIONAL PUMP

Maintenance Agreement Required: ☐ Yes ☑ No

☐ House/Mod. Home No. Bedrooms 3

☑ Mobile Home No. Bathrooms 2

☐ Business No. Employees ____

☐ Other ____


☐ Slab ☑ Crawl Space ☐ Basement w/plumbing ☐ Basement wo/plumbing

Water Supply: ☑ Individual ☐ Community ☐ Public WELL

Comments: ① KEEP SYSTEM MINIMUM 100' FROM WELL
② USE DISTRIBUTION AND DROP BOXES AT LOCATIONS SHOWN TO ACHIEVE SERIAL DISTRIBUTION

Comments:

INITIAL SITE SKETCH

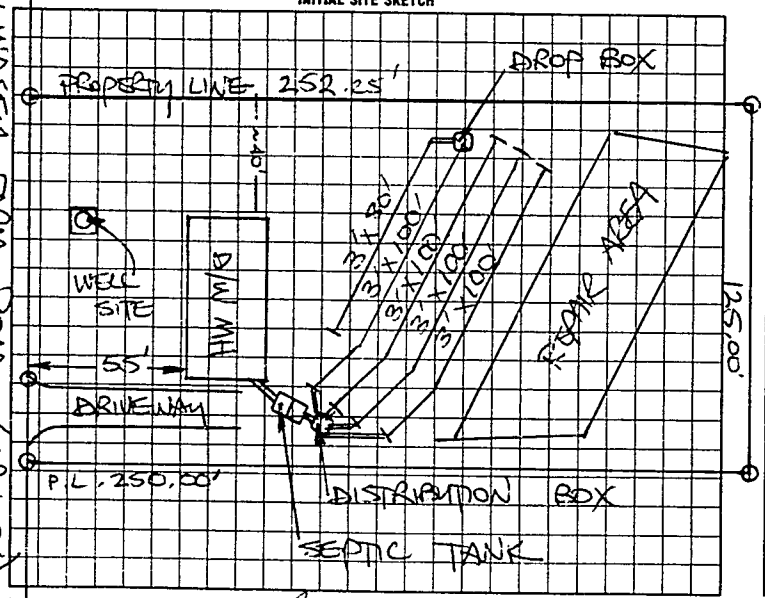

AS BUILT SKETCH

SYSTEM INSTALLED ACCORDING TO INITIAL SITE SKETCH.

I understand that this permit can be suspended or revoked if any false information is supplied toward securing the permit/any unauthorized changes are made to the site/any unauthorized changes are made in the installation of the system.

Signed: David B. Strickland

Improvement Permit by: R.C. Moore date 4-20-96

Existing System Inspection by: R.C. Moore date 4-20-96

Installed by: ROWAN SEPTIC TANK

Certificate of Completion by: ____ date ____

Operation Permit by: STEVE HEDRICK date 10-31-96

TO COURT HEALTH DEPT COPY WHITE — INSPECTION COPY (FINAL) GREEN — OWNER COPY (FINAL) YELLOW — INSPECTION COPY (INITIAL) PINK — OWNER COPY (INITIAL) GOLD

authorization to court EXPIRES 6 mos from issue

167000