IREDELL COUNTY HEALTH DEPARTMENT

STATESVILLE 704-878-5305 MOORESVILLE 704-664-5281

IMPROVEMENT PERMIT / CERTIFICATE OF COMPLETION / OPERATION PERMIT / EXISTING SYSTEM INSPECTION

PROPERTY DESCRIPTION NO. 23432 DATE 4-20-96 TAX MAP NO. 23432 Watershed: ☐ Yes ☐ No

OWNER OR CONTRACTOR Clyde Hall Enterprizes PHONE: Business 6646400 Home

ADDRESS PO Box 1556 Mooresville N.C.

LOCATION old Nation Rd TR Finley Fm Rd 1/2mi Rt

SUBDIVISION LINDSEY FARM Acres BLOCK / SECTION I LOT 8 LOT AREA 0.996 Acres SITE CLASS PS DESIGN FLOW 360 L.T.A.R. 0.30 GPD/FT²

Septic Tank: 1000 Gallons; STB 825 Date 7-3-96
Pump Tank: 1000 Gallons; PT 825 Date 9-8-96
Pump Make: ZOELLER Model N-137C Serial No 137-002-0896
Nitrification Field: No Fields 1 Square Feet 1200 Linear Feet 400
No Lines 4 Trench Width 36" Max Trench Bottom Depth 36" Gravel Depth 12"

☒ New System ☐ Repair System Type I, II, III, IV, V
System Description: CONVENTIONAL PUMP
Repair System Description: CONVENTIONAL PUMP
Maintenance Agreement Required: ☐ Yes ☒ No


☐ House/Mod. Home No Bedrooms 3
☒ Mobile Home No Bathrooms 2
☐ Business No Employees
☐ Other
☐ Slab ☒ Crawl Space ☐ Basement w/plumbing ☐ Basement wo/plumbing

Water Supply: ☒ Individual ☐ Community ☐ Public
WELL


Comments: ① KEEP SYSTEM MINIMUM 100' FROM WELL
② SEE ATTACHED SHEETS FOR PUMP AND PRESSURE MANIFOLD REQUIREMENTS

Comments: SYSTEM CHANGED DUE TO WELL LOCATION

INITIAL SITE SKETCH

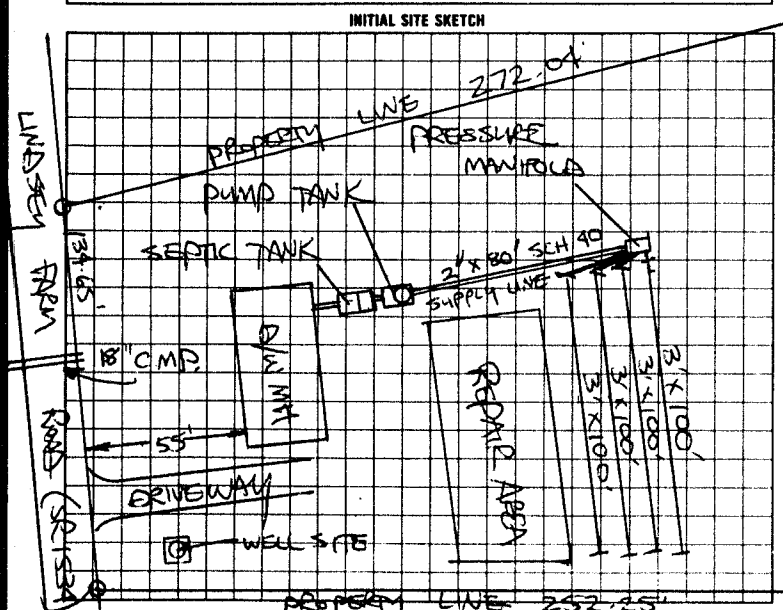

AS BUILT SKETCH

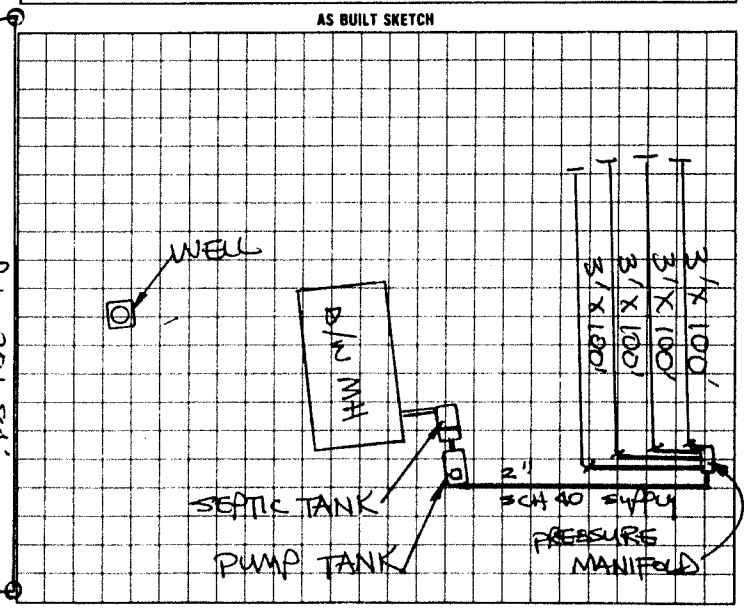

I understand that this permit can be suspended or revoked if any false information is supplied toward securing the permit/any unauthorized changes are made to the site/any unauthorized changes are made in the installation of the system

Signed David B. Stutelack

Improvement Permit by: L. C. Moore date 4-20-96

Existing System Inspection by: L. C. Moore date 4-20-96

Authorization to construct

Installed by ROWAN SEPTIC TANK

Certificate of Completion by _____ date _____

Operation Permit by STEVE HEDRICK date 10-31-96

HEALTH DEPT COPY WHITE INSPECTION COPY (FINAL) GREEN OWNER COPY (FINAL) YELLOW INSPECTION COPY (INITIAL) PINK OWNER COPY (INITIAL) GOLD

authorization to construct expires 6 months from issue