IREDELL COUNTY HEALTH DEPARTMENT

STATESVILLE 704-878-5305 MOORESVILLE 704-664-5281

IMPROVEMENT PERMIT / CERTIFICATE OF COMPLETION / OPERATION PERMIT / EXISTING SYSTEM INSPECTION

PROPERTY DESCRIPTION NO. 23433 DATE 4-20-96 TAX MAP NO. 8UA75 Watershed: ☐ Yes ☐ No

OWNER OR CONTRACTOR Clyde Hall Enterprises PHONE: Business 664 6400 Home

ADDRESS PO Box 1556 mooresville N.C.

LOCATION off rath Rd W TR Pinkney Em Rd 1/2 mi RR

SUBDIVISION LINDSEY FARMACRES BLOCK / SECTION I LOT 9 LOT AREA 0.862 ACRE SITE CLASS PS DESIGN FLOW 360 L.T.A.R. 0.30 GPD/FT

Septic Tank: 1000 Gallons; STB 825 Date 7-10-96
Pump Tank: ____ Gallons; PT ____ Date ____
Pump Make: ____ Model ____ Serial No. ____
Nitrification Field: No Fields 1 Square Feet 1200 Linear Feet 400
No Lines 3 Trench Width 36" Max Trench Bottom Depth 36" Gravel Depth 12"

☑ New System ☐ Repair System Type: I, II, III, IV, V, VI
System Description: CONVENTIONAL GRAVITY
Repair System Description: CONVENTIONAL PUMP
Maintenance Agreement Required: ☐ Yes ☑ No
☐ Slab ☑ Crawl Space ☐ Basement w/plumbing ☐ Basement wo/plumbing


☐ House/Mod. Home No. Bedrooms 3
☑ Mobile Home No. Bathrooms 2
☐ Business No. Employees ____
☐ Other ____

Water Supply:
☑ Individual
☐ Community
☐ Public
WELL

Comments: ① KEEP SYSTEM MINIMUM 100' FROM WELL ② USE ONE DISTRIBUTION BOX TO FEED ALL LINES FROM LOCATION SHOWN USING SERIAL DISTRIBUTION

Comments: Well not located at time of inspection

INITIAL SITE SKETCH

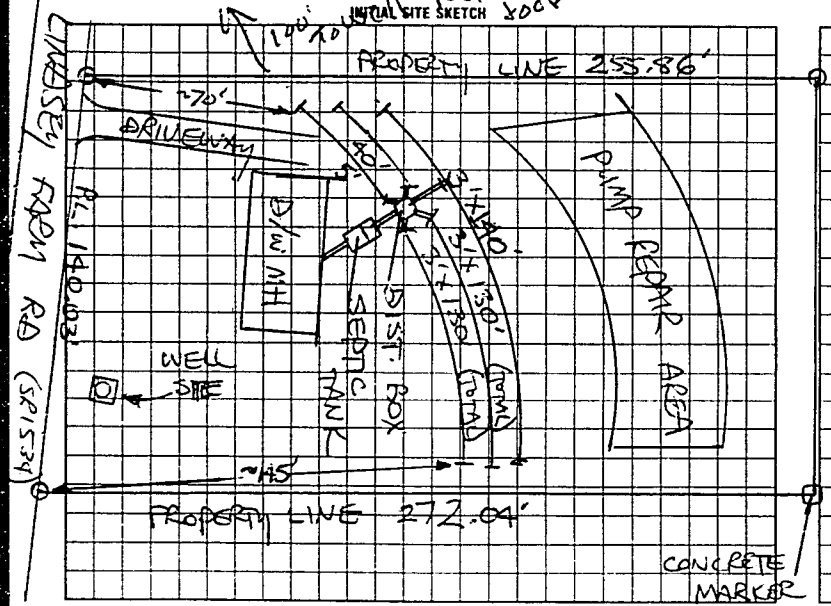

AS BUILT SKETCH

Same as initial sketch

I understand that this permit can be suspended or revoked if any false information is supplied toward securing the permit/any unauthorized changes are made to the site/any unauthorized changes are made in the installation of the system.

Signed: David Stinebaker Installed by: Rowan S.T. Co.

Improvement Permit by: L.C. Moore date 4-20-96 Certificate of Completion by: ____ date ____

Authorization to cover by: L.C. Moore date 4-20-96 Operation Permit by: L.C. Moore date 8-16-96

DEPT COPY WHITE INSPECTION COPY (FINAL) GREEN OWNER COPY (FINAL) YELLOW INSPECTION COPY (INITIAL) PINK OWNER COPY (INITIAL) GOLD

Authorization to cover Expires 60 mos From issue

815000