876-0180 585-2728

# IREDELL COUNTY HEALTH DEPARTMENT

STATESVILLE 704-878-5305 MOORESVILLE 704-664-5281

## IMPROVEMENT PERMIT / CERTIFICATE OF COMPLETION / OPERATION PERMIT / EXISTING SYSTEM INSPECTION

PROPERTY DESCRIPTION NO. 23433 DATE 4-20-96 TAX MAP NO 8614.15 Watershed ☐ Yes ☐ No

OWNER OR CONTRACTOR Clyde Hall Enterprizes PHONE: Business 664-6400 Home

ADDRESS PO Box 1556 Mooresville N.C.

LOCATION old Statesville Rd W TR Pinkney Farm Rd 1/2 mi Rt

SUBDIVISION LINDSEY FARM ACRES BLOCK / SECTION I LOT 9 LOT AREA 8.862 ACRE SITE CLASS P's DESIGN FLOW 360 L.T.A.R. 0.30 GPD/FT²

Septic Tank: 1000 Gallons; STB 825 Date 7-8-96
Pump Tank: Gallons; PT Date
Pump Make: Model Serial No
Nitrification Field: No Fields 1 Square Feet 1200 Linear Feet 400
No Lines 3 Trench Width 36" Max Trench Bottom Depth 36" Gravel Depth 12"

☒ New System ☐ Repair System Type I ☒ III IV V VI
System Description CONVENTIONAL GRAVITY
Repair System Description CONVENTIONAL PUMP
Maintenance Agreement Required ☐ Yes ☒ No
☐ Slab ☒ Crawl Space ☐ Basement w/plumbing ☐ Basement wo/plumbing


☐ House/Mod Home No Bedrooms 3
☒ Mobile Home No Bathrooms 2
☐ Business No Employees
☐ Other

Water Supply
☒ Individual
☐ Community
☐ Public
WELL

Comments ① KEEP SYSTEM MINIMUM 100' FROM WELL ② USE ONE DISTRIBUTION BOX TO FEED ALL LINES, FROM LOCATION SHOWN USING SERIAL DISTRIBUTION

Comments Well not located at time of inspection

INITIAL SITE SKETCH

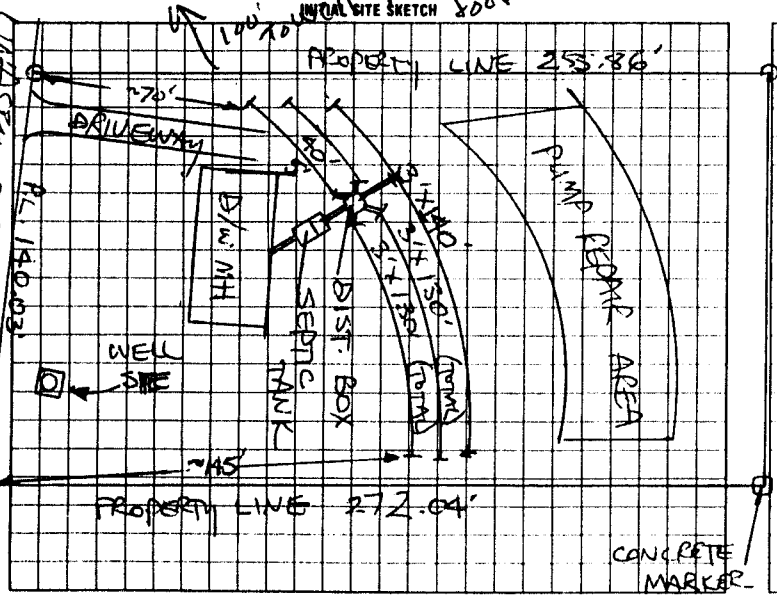


AS BUILT SKETCH

Same as initial sketch

I understand that this permit can be suspended or revoked if any false information is supplied toward securing the permit/any unauthorized changes are made to the site/any unauthorized changes are made in the installation of the system

Signed: David Stinebaugh

Improvement Permit by L.C. Moore date 4-20-96

Existing System Inspection by ~~L.C. Moore~~ date ~~4-20-96~~

Installed by Rowan S.T. Co.

Certificate of Completion by date

Operation Permit by L.C. Moore date 8-16-96

to county

INSPECTION COPY (FINAL) GREEN OWNER COPY (FINAL) YELLOW INSPECTION COPY (INITIAL) PINK OWNER COPY (INITIAL) GOLD

Authorization to count EXPIRES 60 mos FROM ISSUE