IREDELL COUNTY HEALTH DEPARTMENT

STATESVILLE 704-878-5305 MOORESVILLE 704-664-5281

IMPROVEMENT PERMIT / CERTIFICATE OF COMPLETION / OPERATION PERMIT / EXISTING SYSTEM INSPECTION

PROPERTY DESCRIPTION NO. 23434 DATE 4-20-96 TAX MAP NO. 8UA 75 Watershed: ☐ Yes ☐ No

OWNER OR CONTRACTOR Clyde Hall Enterprises PHONE: Business 664-6400 Home

ADDRESS PO Box 1556 Mooresville, N.C.

LOCATION Old Mtn Rd W TR Finley Farm Rd 1/2 mi on Rt

SUBDIVISION LINDSEY FARM ACRES BLOCK / SECTION I LOT 10 LOT AREA 0.753 SITE CLASS PS DESIGN FLOW 360 L.T.A.R. 0.30 @ PD/AR

Septic Tank: 1000 Gallons; STB 615 Date 6-20-96
Pump Tank: Gallons; PT Date
Pump Make: Model Serial No.
Nitrification Field: No Fields 1 Square Feet 1200 Linear Feet 400
No Lines 4 Trench Width 36" Max Trench Bottom Depth 36" Gravel Depth 12"

☑ New System ☐ Repair System Type: I, II, III, IV, V, VI
System Description: CONV. GRAVITY
Repair System Description: CONV. GRAVITY
Maintenance Agreement Required: ☐ Yes ☑ No

☐ House/Mod. Home ☑ Mobile Home ☐ Business ☐ Other
No. Bedrooms 3 No. Bathrooms 2 No. Employees


☐ Slab ☑ Crawl Space ☐ Basement w/plumbing ☐ Basement wo/plumbing

Water Supply: ☑ Individual ☐ Community ☐ Public WELL


Comments: ① KEEP WELL MINIMUM 100' FROM SYSTEM.
② USE THREE FLOW DIVIDER TEES TO ACHIEVE EQUAL DISTRIBUTION INTO EACH OF FOUR 100' LINES

Comments:

INITIAL SITE SKETCH

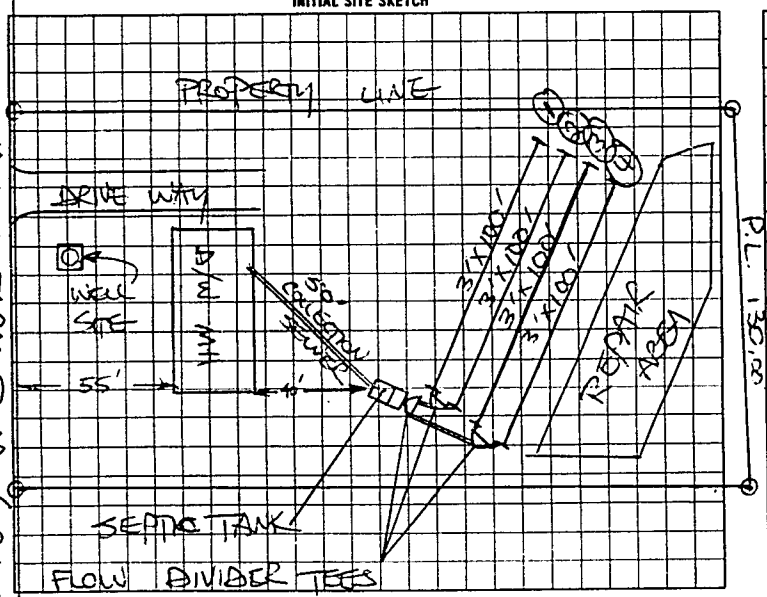

AS BUILT SKETCH

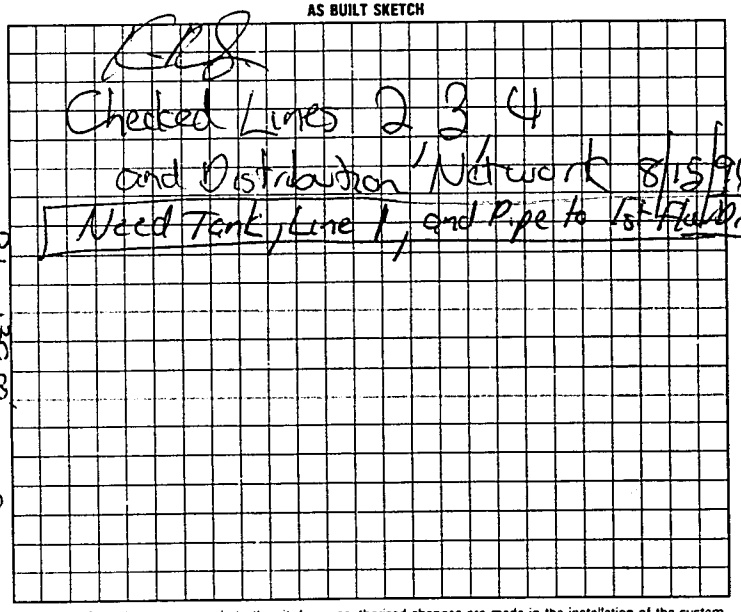

I understand that this permit can be suspended or revoked if any false information is supplied toward securing the permit/any unauthorized changes are made to the site/any unauthorized changes are made in the installation of the system.

Signed: David B. Stakelbeck

Installed by: Ronan S.T. Co.

Improvement Permit by: L.C. Moore date 4-20-96

Certificate of Completion by: date

Authorization Existing System Inspected by: L.C. Moore date 4-20-96

Operation Permit by: L.C. Moore date 8-16-96

to count HEALTH DEPT COPY WHITE — INS. ECTION COPY (FINAL) GREEN — Authorization to count — OWNER COPY (FINAL) YELLOW — INSPECTION COPY (INITIAL) PINK — Expires 60 mos from issue — OWNER COPY (INITIAL) GOLD

$15000