IREDELL COUNTY HEALTH DEPARTMENT

STATESVILLE 704-878-5305 MOORESVILLE 704-664-5281

IMPROVEMENT PERMIT / CERTIFICATE OF COMPLETION / OPERATION PERMIT / EXISTING SYSTEM INSPECTION

PROPERTY DESCRIPTION NO. 2516 9 067139 DATE 12-7-96 TAX MAP NO. Pt 8M-A-76 Watershed: ☐ Yes ☑ No

OWNER OR CONTRACTOR Clyde Hall PHONE: Business 585 2728 Home

ADDRESS P.O. Box 1556 Mooresville

LOCATION old Mtn Rd TR Lindsey TR Barley Lane Th millet Drive attend left

SUBDIVISION Lindsey Fm BLOCK / SECTION LOT 16 LOT AREA 1.06± A. SITE CLASS. PS DESIGN FLOW 360 L.T.A.R. .3

Septic Tank: 1000 Gallons; STB 425 Date 4-11-97

Pump Tank: Gallons; PT Date

Pump Make: Model Serial No

Nitrification Field: No Fields 1 Square Feet 900 Linear Feet 300

No Lines 3 Trench Width 36" Max Trench Bottom Depth 36" Gravel Depth N/A

☑ New System ☐ Repair System Type: I, II, (III) IV, V, VI

System Description: Gravity Chambers 12 11

Repair System Description:

Maintenance Agreement Required: ☐ Yes ☑ No

☐ House/Mod. Home No. Bedrooms 3

☐ Mobile Home No. Bathrooms 2

☐ Business No. Employees

☐ Other


☐ Slab ☑ Crawl Space ☐ Basement w/plumbing ☐ Basement wo/plumbing

Water Supply: ☑ Individual ☐ Community ☐ Public

Comments:


250'

INITIAL SITE SKETCH

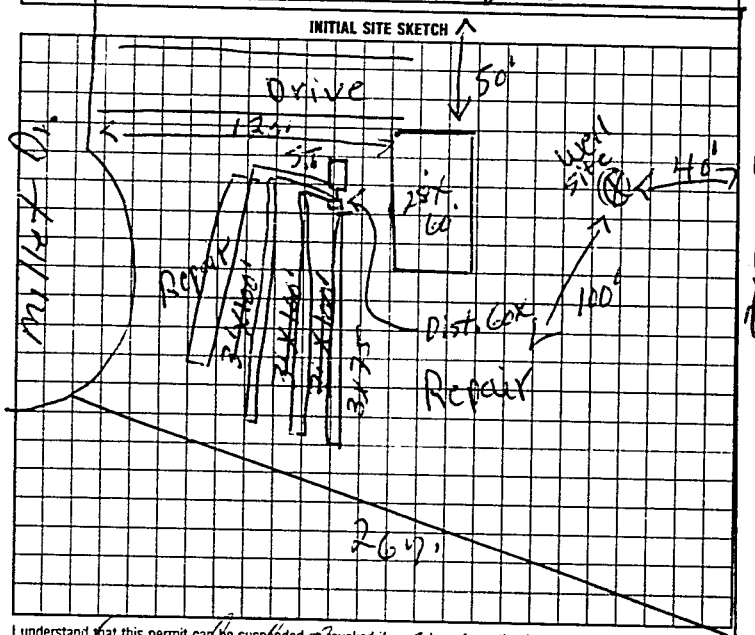

Comments:

AS BUILT SKETCH

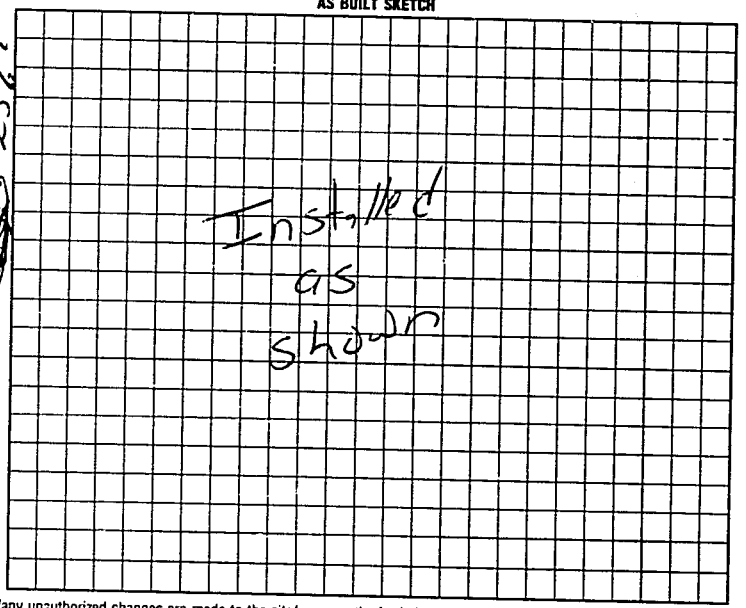

I understand that this permit can be suspended or revoked if any false information is supplied toward securing the permit/any unauthorized changes are made to the site/any unauthorized changes are made in the installation of the system. Improvement Permit is valid for 60 months from date of issuance.

Signed:

Improvement Permit by: R.C. Moore date 12-7-96

Authorization to Cover Existing System Inspection by: R.C. Moore date 12-7-96

Installed by: Rowan Septic

Certificate of Completion by: date

Operation Permit by: Approved as Constructed date 6-26-97

HEALTH DEPT. COPY: WHITE INSPECTION COPY (FINAL): GREEN OWNER COPY (FINAL): YELLOW INSPECTION COPY (INITIAL): PINK OWNER COPY (INITIAL): GOLD

Authorization to Cover Expires 60 Days from Issue

to cover.