IREDELL COUNTY HEALTH DEPARTMENT

STATESVILLE 704-878-5305 MOORESVILLE 704-664-5281

IMPROVEMENT PERMIT / CERTIFICATE OF COMPLETION / OPERATION PERMIT / EXISTING SYSTEM INSPECTION

PROPERTY DESCRIPTION NO. 23435 DATE 4-20-96 TAX MAP NO. 8U A 75 Watershed: ☐ Yes ☐ No

OWNER OR CONTRACTOR Clyde Hall Enterprises PHONE: Business 664 6400 Home

ADDRESS P.O. Box 1556 Mocksville N.C.

LOCATION Old Nath Rd West TR Winston Fm Rd TR 1/2 mi on Rt.

SUBDIVISION LINDSEY FARM ACRES BLOCK / SECTION I LOT 41 LOT AREA 0.746 AC SITE CLASS. PS DESIGN FLOW 360 L.T.A.R. 0.306 GPD/FT²

Septic Tank: 1000 Gallons; STB SAS Rowan Date 7/16/96

Pump Tank: _____ Gallons; PT _____ Date _____

Pump Make: _____ Model _____ Serial No. _____

Nitrification Field: No Fields 1 Square Feet 1200 Linear Feet 400

No Lines 4 Trench Width 36" Max Trench Bottom Depth 18-36" Gravel Depth 12"

☑ New System ☐ Repair System Type: I II III IV V VI

System Description: CONVENTIONAL GRAVITY

Repair System Description: CONV. GRAVITY

Maintenance Agreement Required: ☐ Yes ☑ No

☐ House/Mod. Home ☑ Mobile Home ☐ Business ☐ Other

No. Bedrooms 3 No. Bathrooms 2 No. Employees ____


☐ Slab ☐ Crawl Space ☐ Basement w/plumbing ☐ Basement wo/plumbing

Water Supply: ☑ Individual ☐ Community ☐ Public WELL


Comments: ① KEEP SYSTEM MINIMUM 100' FROM WELL ② USE THREE FLOW DIVIDER TEES TO ACHIEVE EQUAL DISTRIBUTION INTO EACH OF FOUR 100' LINES

Comments:

INITIAL SITE SKETCH

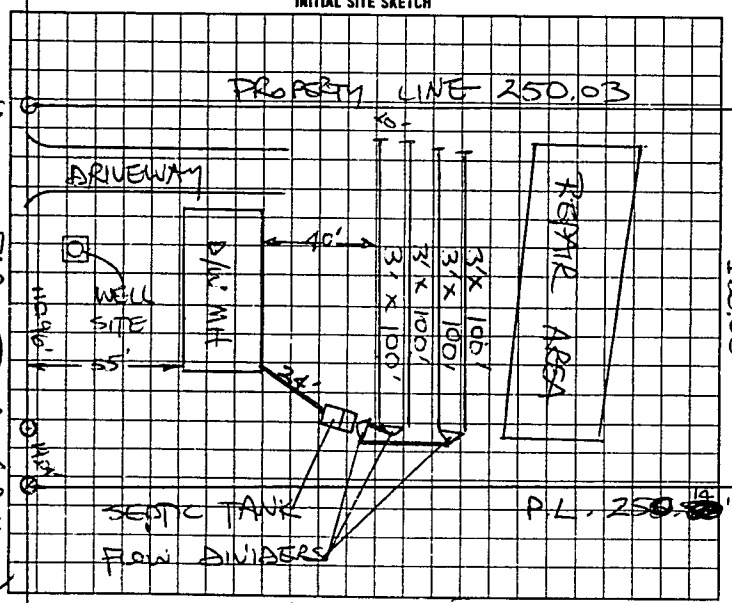

AS BUILT SKETCH

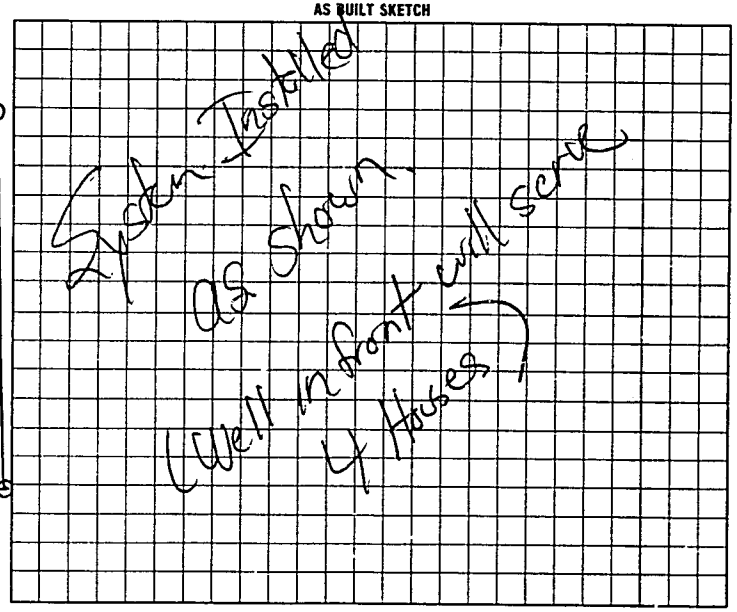

I understand that this permit can be suspended or revoked if any false information is supplied toward securing the permit/any unauthorized changes are made to the site/any unauthorized changes are made in the installation of the system

Signed: David B. Strickland

Improvement Permit by: R.C. Moore date 4-20-96

Authorization to Construct by: R.C. Moore date 4-20-96

Installed by: Rowan Septic Tank

Certificate of Completion by: _____ date _____

Operation Permit by: _____ date 8/16/96

to Construct COPY WHITE | INSPECTION COPY (FINAL) GREEN | OWNER COPY (FINAL) YELLOW | INSPECTION COPY (INITIAL) PINK | OWNER COPY (INITIAL) GOLD

Authorization to Construct Expires 6 mos from issue

225000