IREDELL COUNTY HEALTH DEPARTMENT

STATESVILLE 704-878-5305 MOORESVILLE 704-664-5281

IMPROVEMENT PERMIT / AUTHORIZATION TO CONSTRUCT / OPERATION PERMIT / EXISTING SYSTEM INSPECTION

PERMIT# 121089 PIN# 3796-42-5230 DATE 5-21-04

OWNER OR CONTRACTOR CITY OF STATESVILLE PHONE: Business 704-682-4396 Home

ADDRESS 1391 WEST VALLEY LANE, STONY POINT NC 28678

LOCATION I-40 WEST TR OLD MOUNTAIN ROAD, TR LINASEY FARM RD, TL WEST VALLEY LANE, 7TH LOT ON LEFT

SUBDIVISION WEST VALLEY ACRES BLOCK/SECTION LOT 7 LOT AREA 125' x 200' SITE CLASS. PS' DESIGN FLOW 240 L.T.A.R. 0.25 GAD/FT²

Septic Tank: 1000 Gallons; STB 786 Date 3-20-04
Pump Tank: Gallons; PT Date
Pump Make: Model Serial No.
Nitrification Field: No Fields 1 Square Feet 960 Linear Feet 320
No Lines FIVE Trench Width 36" Max Trench Bottom Depth 36" Gravel Depth 12"

☑ New System ☐ Repair System Type: I, (II), III, IV, V, VI
System Description: CONVENTIONAL GRAVITY
Repair System Description: 25% REDUCTION, PUMP
Maintenance Agreement Required: ☐ Yes ☑ No


☐ House/Mod. Home No. Bedrooms 2
☑ Mobile Home No. Bathrooms 2
☐ Business No. Employees
☐ Other
☐ Slab ☑ Crawl Space ☐ Basement w/plumbing ☐ Basement wo/plumbing

Water Supply: ☐ Individual ☑ Public ☐ Community


Comments:/Conditions: INSTALL DRAINLINES ON CONTOUR AS FLAGGED

Comments:/Conditions: -ST Marker + Blue Plexiglass Filter Installed

INITIAL SITE SKETCH

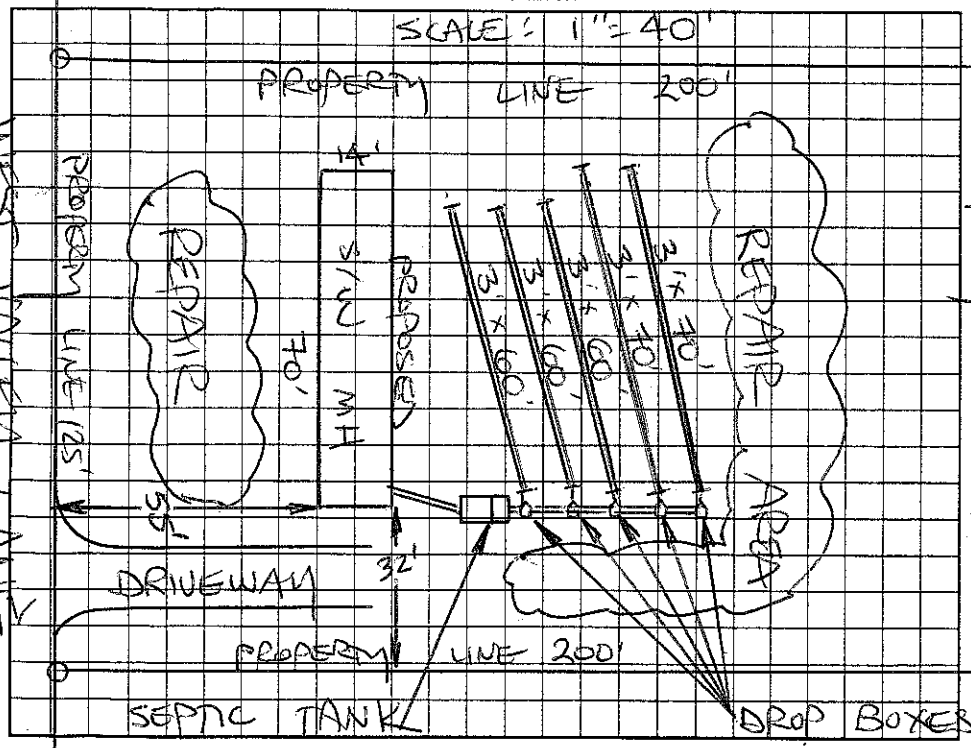

AS BUILT SKETCH

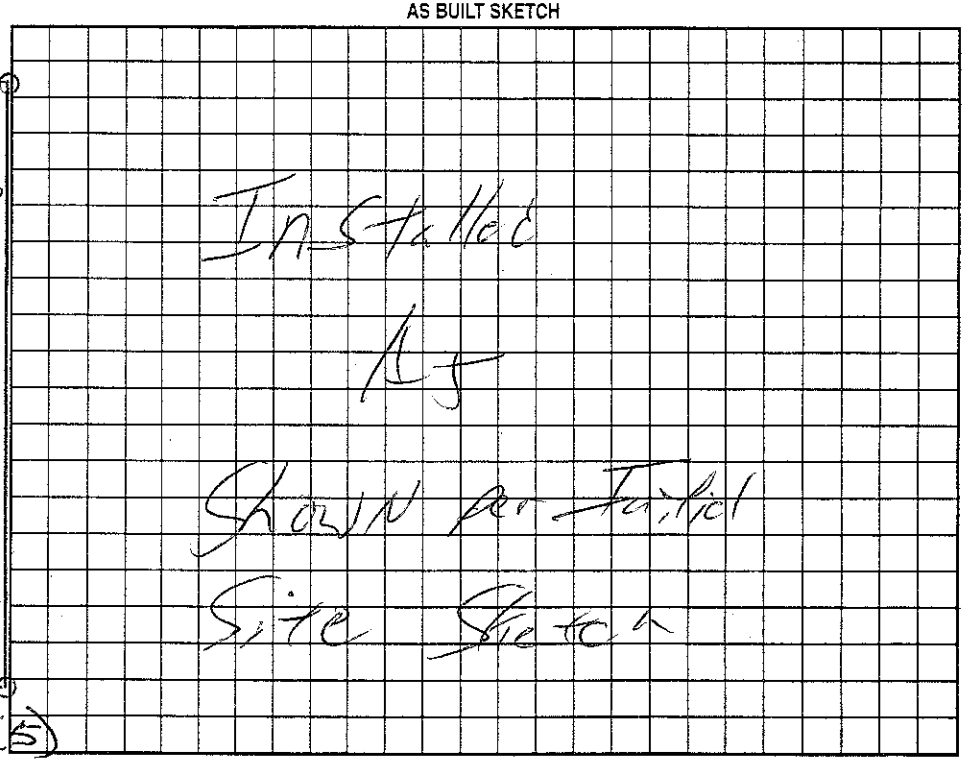

Permit can be suspended or revoked if any false information is supplied toward securing the permit/any unauthorized changes are made to the site/any unauthorized changes are made in the installation of the system. Improvement Permit with plat valid without expiration. Improvement Permit with site plan valid for sixty months. Authorization to Construct is valid for a period equal to that of Improvement Permit – not to exceed sixty months.

Signed: Danny Mella 5-25-04 date Installed by: Charlie Bryce

Improvement Permit by: STEVE HEDRICK date 5-21-04 Operation Permit by: William S. John date 7/8/04

Authorization to Construct by: STEVE HEDRICK date 5-21-04 Existing System Inspection by: date

HEALTH DEPT. COPY: WHITE OWNER COPY (FINAL): YELLOW OWNER COPY (INITIAL): PINK