IREDELL COUNTY HEALTH DEPARTMENT

(11:00)

STATESVILLE 704-878-5305

Voids Previous Permits

MOORESVILLE 704-664-5281

IMPROVEMENT PERMIT / AUTHORIZATION TO CONSTRUCT / OPERATION PERMIT / EXISTING SYSTEM INSPECTION

PERMIT# 84376 PIN# 3796429039 DATE June 14 00

OWNER OR CONTRACTOR Sunwood Builders PHONE: Business 872-5422 Home

ADDRESS PO Box 5877 Statesville

LOCATION Old MTRd N (R) Lindsey Farm (L) Greenmont 5th Lot on left at end of Cul de Sac

SUBDIVISION BLOCK / SECTION LOT LOT AREA SITE CLASS DESIGN FLOW L.T.A.R. = 33

Septic Tank: 1000 Gallons; STB 1012 Date 2-17-00

Pump Tank: Gallons; PT Date

Pump Make: Model Serial No

Nitrification Field: No Fields 1 Square Feet 1454 Linear Feet 480

No Lines 4 Trench Width 36" Max Trench Bottom Depth 36" Gravel Depth 12"

☑ New System ☐ Repair System Type: I II III IV V VI

System Description: Conventional Gravity

Repair System Description: Same Reduction Possible

Maintenance Agreement Required: ☐ Yes ☑ No

☑ House/Mod. Home ☐ Mobile Home ☐ Business ☐ Other

No. Bedrooms 4 No. Bathrooms 3 No. Employees

☐ Slab ☑ Crawl Space ☐ Basement w/plumbing ☐ Basement wo/plumbing

Water Supply: ☐ Individual ☐ Public ☐ Community

MBU


Comments:/Conditions: Install on Contour

Keep well 100ft or max feasible distance from Septic System (50ft min)


well

Comments:/Conditions:

INITIAL SITE SKETCH

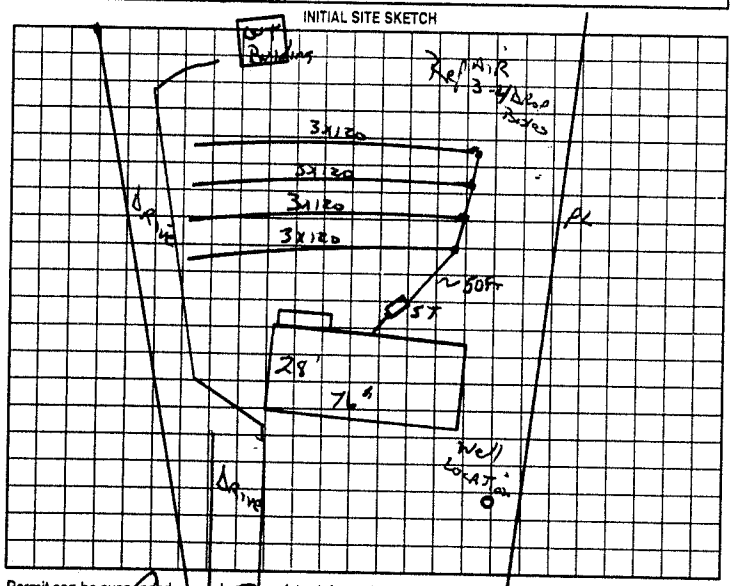

AS BUILT SKETCH

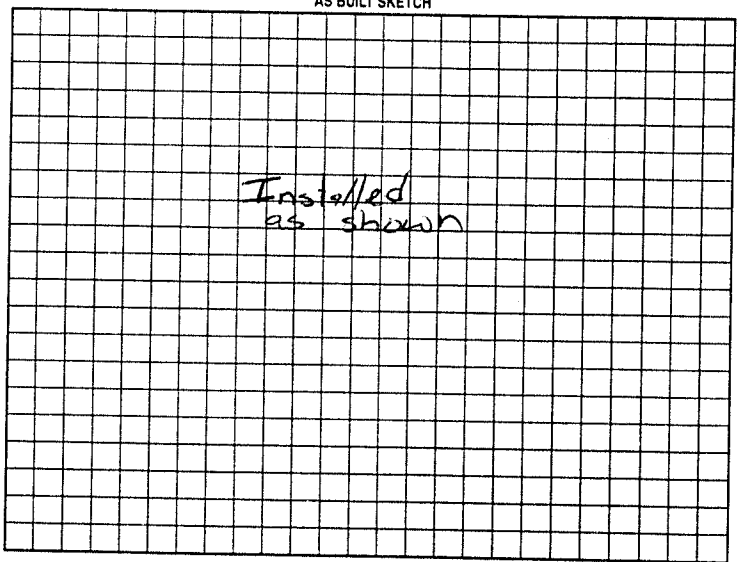

Permit can be suspended or revoked if any false information is supplied toward securing the permit/any unauthorized changes are made to the site/any unauthorized changes are made in the installation of the system. Improvement Permit with plat valid without expiration. Improvement Permit with site plan valid for sixty months. Authorization to Construct is valid for a period equal to that of Improvement Permit – not to exceed sixty months.

Signed: date 6/14/00 Installed by: Tommy Frye

Improvement Permit by: Lyle Potter date June 14 2000 Operation Permit by: Mark Craig date 6-20-00

Authorization to Construct by: Lyle Potter date June 14 2000 Existing System Inspection by: date

HEALTH DEPT. COPY. WHITE OWNER COPY (FINAL): YELLOW OWNER COPY (INITIAL): PINK