IREDELL COUNTY HEALTH DEPARTMENT

STATESVILLE 704-878-5305 MOORESVILLE 704-664-5281

IMPROVEMENT PERMIT / CERTIFICATE OF COMPLETION / OPERATION PERMIT / EXISTING SYSTEM INSPECTION

PROPERTY DESCRIPTION NO. Repair DATE 3-29-94 TAX MAP NO. Repair / 3796.49.9254 Watershed: ☐ Yes ☑ No

OWNER OR CONTRACTOR Roger Lackey PHONE: Business Home 585-2459

ADDRESS Rt. 1 Box 309 Stanly Pt., N.C. 28678 now 501 N. Lackey Farm Rd.

LOCATION I40W TR Hwy 90 TL 2nd entrance to Lackey Farm Rd. go across new Hwy 90 1st Brick house on R.

SUBDIVISION NA BLOCK / SECTION — LOT — LOT AREA ±1.5 acre SITE CLASS. P.S. DESIGN FLOW 360 L.T.A.R. Repair

Septic Tank: Existing Gallons; STB — Date —
Pump Tank: — Gallons; PT — Date —
Pump Make: — Model — Serial No. —
Nitrification Field: No Fields 2 Square Feet 630 Linear Feet 210'
No Lines 3 Trench Width 36" Max Trench Bottom Depth 30" Gravel Depth 12"

☐ New System ☑ Repair System Type: I, II, III, IV, V, VI
System Description: Conventional, gravity fed
Repair System Description:
Maintenance Agreement Required: ☐ Yes ☑ No
☐ Slab ☐ Crawl Space ☑ Basement w/plumbing ☐ Basement wo/plumbing


☑ House/Mod. Home No. Bedrooms 3
☐ Mobile Home No. Bathrooms 3
☐ Business No. Employees
☐ Other

Water Supply: ☑ Individual ☐ Community ☐ Public

Comments: Install repair lines. Install interceptor drain around both systems. Install interceptor drain min 6" wide, 4' deep, and gravel up to 6" of surface with corrigatted pipe in line or trench. (Slotted pipe). Run ±130' long and run to daylight. Keep repair lines 6' from existing system, 10' from property lines, 10' from water line, and 10' from interceptor drain.

Comments: Drainlines Inspected 4-29-94. Washing machine drain tied into plumbing in house. French drain not inspected from end of gravel to daylight. Inspected after covered up. 10-14-94

INITIAL SITE SKETCH

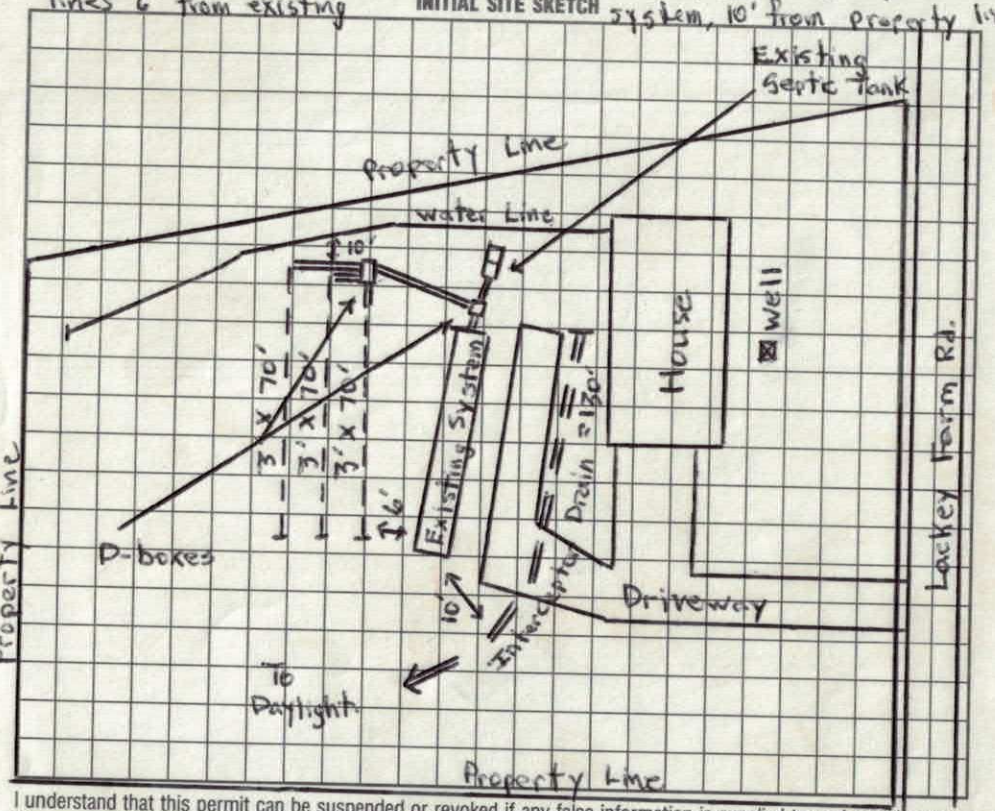

AS BUILT SKETCH

10' from interceptor drain.
Install washing machine drain into septic system, check integrity of septic tank, install new sanitary tee if needed.

* Call for inspection of interceptor drain before installing gravel.

* Repair must be installed before 4-30-94.

I understand that this permit can be suspended or revoked if any false information is supplied toward securing the permit/any unauthorized changes are made to the site/any unauthorized changes are made in the installation of the system. Improvement Permit is valid for 60 months from date of issuance.

Signed: Roger Lackey

Improvement Permit by: Michael J. Dennis date 3-29-94

Existing System Inspection by: date

Installed by: Harry Reep

Certificate of Completion by: Michael J. Dennis date 10-14-94

Operation Permit by: date

HEALTH DEPT. COPY: WHITE INSPECTION COPY (FINAL): GREEN OWNER COPY (FINAL): YELLOW INSPECTION COPY (INITIAL): PINK OWNER COPY (INITIAL): GOLD

HEALTH, & NATURAL RESOURCES
DIVISION OF ENVIRONMENTAL HEALTH
ON-SITE WASTEWATER SECTION

PROPERTY I.D.#:
PROPERTY RECORDED:
COUNTY: Iredell

SOIL/SITE EVALUATION
FOR
ON-SITE WASTEWATER SYSTEM

APPLICANT: Roger Lackey OWNER: AGENT: PHONE:
ADDRESS: APPLICATION DATE: DATE EVALUATED:
PROPOSED FACILITY:
PROPERTY SIZE:
LOCATION OF SITE: Lackey Farm Rd.
WATER SUPPLY: On-Site Well ✓ Comm. Well Public Other EVAL. METHOD: Auger Boring ✓ Pit Cut

PROFILE #	.1940 LANDSCP POS./ SLOPE %	HORIZON DEPTH (IN.)	.1941 (a)(1) TEXTURE	.1941 (a)(2) STRUCTURE	.1941 (a)(3) MINEROLOGY	
1	3-5% L	0-4"	l	gr	1:1 / vfr	.1942 WETNES CONDITION - P.S.
		4"-48"	c	sbk	1:1 / fr	.1943/.1956 SAPROLITE - NA
						.1944 RESTRICTIVE HORIZON - NA
						.1948 PROFILE CLASSIFICATION - P.S.
						PROFILE LTAR - .35
2						.1942 WETNES CONDITION -
						.1943/.1956 SAPROLITE -
						.1944 RESTRICTIVE HORIZON -
						.1948 PROFILE CLASSIFICATION -
						PROFILE LTAR -
3						.1942 WETNESS CONDITION -
						.1943/.1956 SAPROLITE -
						.1944 RESTRICTIVE HORIZON -
						.1948 PROFILE CLASSIFICATION -
						PROFILE LTAR -
4						.1942 WETNESS CONDITION -
						.1943/.1956 SAPROLITE -
						.1944 RESTRICTIVE HORIZON -
						.1948 PROFILE CLASSIFICATION -
						PROFILE LTAR -
5						.1942 WETNESS CONDITION -
						.1943/.1956 SAPROLITE -
						.1944 RESTRICTIVE HORIZON -
						.1948 PROFILE CLASSIFICATION -
						PROFILE LTAR -

AVAILABLE SPACE (.1945) P.S. SITE CLASSIFICATION (.1948): P.S. SITE LONG-TERM ACCEPTANCE RATE: .35
OTHER FACTORS(.1946) SYSTEM TYPE
EVALUATED BY: Michael A. Owens OTHER(S) PRESENT: Repair (Roger Lackey)
COMMENTS:

DRAFT