60797

IREDELL COUNTY HEALTH DEPARTMENT

STATESVILLE 704-878-5305 MOORESVILLE 704-664-5281

IMPROVEMENT PERMIT / CERTIFICATE OF COMPLETION / OPERATION PERMIT / EXISTING SYSTEM INSPECTION

PROPERTY DESCRIPTION NO. [redacted] 23436 DATE 4-20-96 TAX MAP NO. 8U A 175 Watershed: ☐ Yes ☒ No

OWNER OR CONTRACTOR Clyde Hall Enterprises PHONE: Business 664 6401 Home

ADDRESS Po Box 1551 Mooresville, N.C.

LOCATION 01 mtn Rd TR Finley Farm Rd 1/2 mi Rt

SUBDIVISION LINDSEY FARM ACRES BLOCK / SECTION I LOT 12 LOT AREA 90,717 Ac. SITE CLASS. PS DESIGN FLOW 360 L.T.A.R. 0.30 GPD/FT²

Septic Tank: 1000 Gallons; STB 825 Date 3-13-96

Pump Tank: _____ Gallons; PT _____ Date _____

Pump Make: _____ Model _____ Serial No. _____

Nitrification Field: No Fields 1 Square Feet 1200 Linear Feet 400

No Lines 4 Trench Width 36" Max Trench Bottom Depth 36" Gravel Depth 12"

☒ New System ☐ Repair System Type: I (II) III. IV. V. VI

System Description: CONVENTIONAL GRAVITY

Repair System Description: CONV. GRAVITY

Maintenance Agreement Required: ☐ Yes ☒ No

☐ House/Mod. Home No. Bedrooms 3

☒ Mobile Home No. Bathrooms 2

☐ Business No. Employees ____

☐ Other _____


☐ Slab ☒ Crawl Space ☐ Basement w/plumbing ☐ Basement wo/plumbing

Water Supply: ☒ Individual ☐ Community ☐ Public WELL

Comments: ① KEEP WELL MINIMUM 100' FROM SYSTEM ② USE THREE FLOW DIVIDER TEES TO ACHIEVE EQUAL DISTRIBUTION INTO EACH OF FOUR 100' LINES.

Comments: Checked S.T. 5-16-96 JCM

INITIAL SITE SKETCH

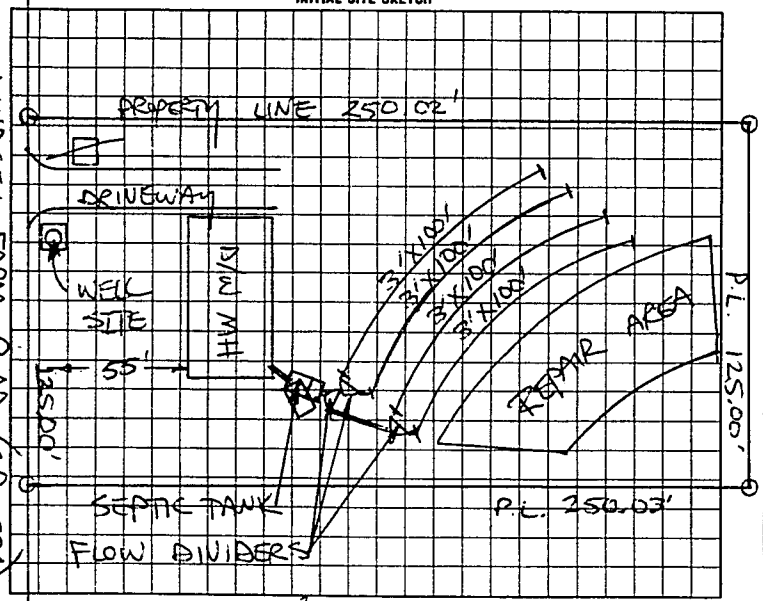

AS BUILT SKETCH

Same as initial sketch

I understand that this permit can be suspended or revoked if any false information is supplied toward securing the permit/any unauthorized changes are made to the site/any unauthorized changes are made in the installation of the system.

Signed David B. Stinebaltha

Improvement Permit by: R. C. Moore date 4-20-96

Authorization Existing System Inspection by: R. C. Moore date 4-20-96

Authorization to count

Installed by: Rowan S.T. Co.

Certificate of Completion by: _____ date _____

Operation Permit by: R. C. Moore date 7-2-96

Authorization to count Expires 6 mos from issue

HEALTH DEPT COPY WHITE INSPECTION COPY (FINAL) GREEN OWNER COPY (FINAL) YELLOW INSPECTION COPY (INITIAL) PINK OWNER COPY (INITIAL) GOLD

60S000