IREDELL COUNTY HEALTH DEPARTMENT

STATESVILLE 704-878-5305 MOORESVILLE 704-664-5281

IMPROVEMENT PERMIT / AUTHORIZATION TO CONSTRUCT / OPERATION PERMIT / EXISTING SYSTEM INSPECTION

PERMIT# 077824 PIN# 3796 51 0603 DATE 11-10-98

OWNER OR CONTRACTOR STIKELEATHER & ASSOC. PHONE: Business 585-2728 Home

ADDRESS 267 LINASEY FARM ROAD STONY POINT NC 28678

LOCATION I-40 W, TR OLD MTN ROAD, TR LINASEY FARM ROAD, ~1.6 MILE ON LEFT

SUBDIVISION WEST IREDELL BLOCK / SECTION LOT 25 LOT AREA 0.57 ACRE SITE CLASS PS DESIGN FLOW 360 LTAR 0.80 GPD/FT²

Septic Tank: 1000 Gallons, STB 825 Date 10-3-98

Pump Tank: Gallons; PT Date

Pump Make: Model Serial No.

Nitrification Field: No Fields 1 Square Feet 1200 Linear Feet 400

No Lines FIVE Trench Width 36" Max Trench Bottom Depth 36" Gravel Depth 12"

☑ New System ☐ Repair System Type: I II III IV V VI

System Description: CONVENTIONAL GRAVITY

Repair System Description: CONV. PUMP/GRAVITY

Maintenance Agreement Required: ☐ Yes ☑ No

☐ House/Mod. Home ☑ Mobile Home ☐ Business ☐ Other

No. Bedrooms 3 No. Bathrooms 2 No. Employees


☐ Slab ☑ Crawl Space ☐ Basement w/plumbing ☐ Basement wo/plumbing

Water Supply: ☑ Individual ☐ Public ☐ Community WELL


Comments/Conditions: ① LANDSCAPE BACK YARD TO TAKE DRAINAGE AWAY FROM SYSTEM ② KEEP SYSTEM MINIMUM 100 FEET FROM WELL

Comments/Conditions:

INITIAL SITE SKETCH SCALE: 1"=40'

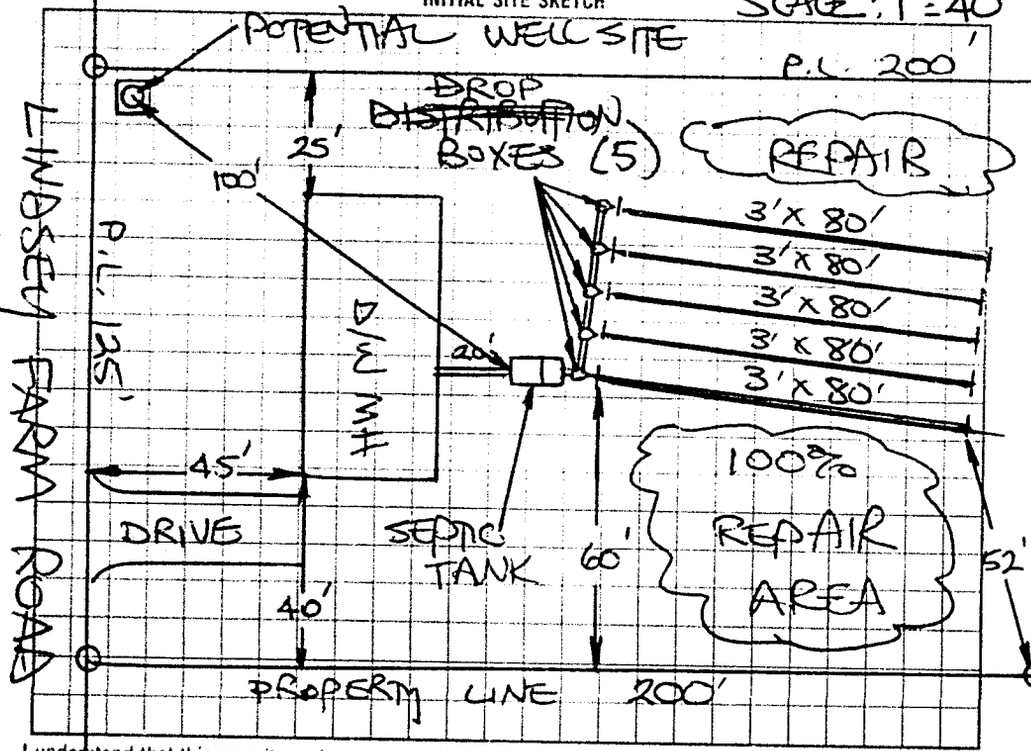

AS BUILT SKETCH

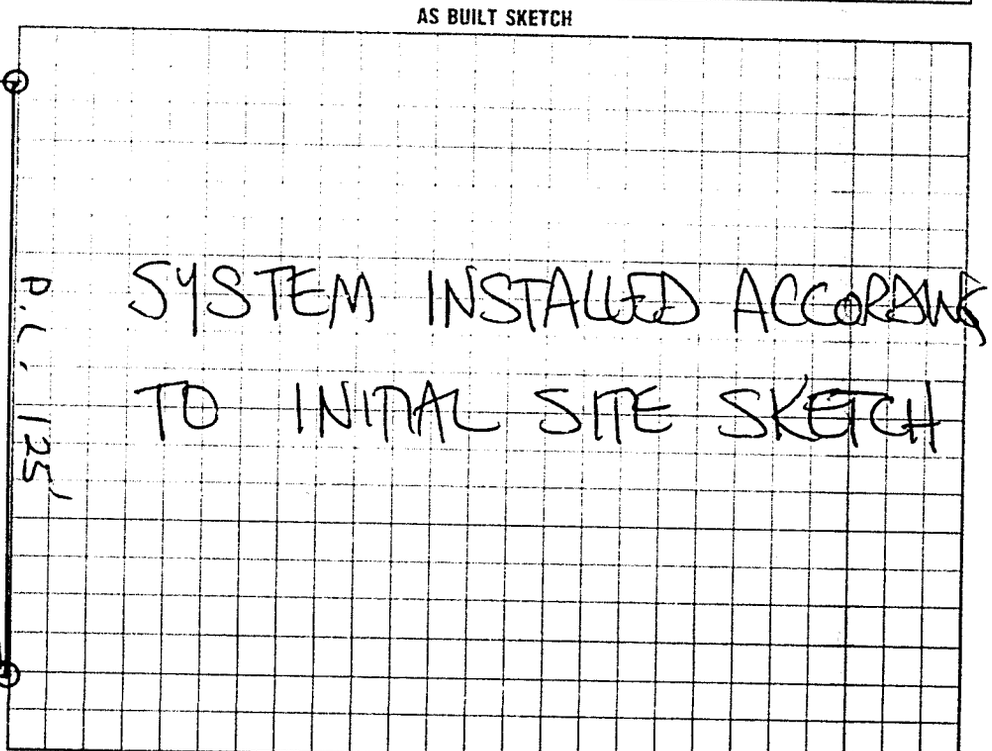

I understand that this permit can be suspended or revoked if any false information is supplied toward securing the permit/any unauthorized changes are made to the site/any unauthorized changes are made in the installation of the system. Improvement Permit with plat valid without expiration. Improvement Permit with site plan valid for sixty months. Authorization to Construct is valid for a period equal to that of Improvement Permit – not to exceed sixty months.

Signed: David Stikeleather

Improvement Permit by: STEVE HEDRICK date 11-10-98

Authorization to Construct by: STEVE HEDRICK date 11-10-98

Installed by: C & W GRADING

Operation Permit by: STEVE HEDRICK date 12-11-98

Existing System Inspection by date

HEALTH DEPT. COPY: WHITE INSPECTION COPY (FINAL): GREEN OWNER COPY (FINAL): YELLOW INSPECTION COPY (INITIAL): PINK OWNER COPY (INITIAL): GOLD