IREDELL COUNTY HEALTH DEPARTMENT

STATESVILLE 704-878-5305 MOORESVILLE 704-664-5281

PROVEMENT PERMIT / CERTIFICATE OF COMPLETION / OPERATION PERMIT / EXISTING SYSTEM INSPECTION

PROPERTY DESCRIPTION NO. 25166 DATE 11-6-96 TAX MAP NO. 8W-A-26 Pt Watershed: ☐ Yes ☐ No

OWNER OR CONTRACTOR Clyfe Hall Est. PHONE: Business 585-2725 Home

ADDRESS PO Box 1556 Mooresville, NC

LOCATION Old Mtn Rd Turn Lintsey Rd TR Barkley Ln TL Millet Dr. atent

SUBDIVISION Lintsey Fm Acres BLOCK / SECTION LOT 15 LOT AREA 2.59 acres SITE CLASS. PS DESIGN FLOW 360 L.T.A.R. .3

Septic Tank: 1000 Gallons; STB 825 Date 10-9-96
Pump Tank: Gallons; PT Date
Pump Make: Model Serial No.
Nitrification Field: No Fields 1 Square Feet 1200 Linear Feet 400
No Lines 4 Trench Width 36" Max Trench Bottom Depth 36" Gravel Depth 12"

☑ New System ☐ Repair System Type: I, II, III, IV, V, VI
System Description: Conv. Gravity
Repair System Description:
Maintenance Agreement Required: ☐ Yes ☑ No

☐ House/Mod. Home ☑ Mobile Home ☐ Business ☐ Other
No. Bedrooms 3 No. Bathrooms 2 No. Employees


☐ Slab ☑ Crawl Space ☐ Basement w/plumbing ☐ Basement wo/plumbing

Water Supply: ☑ Individual ☐ Community ☐ Public


Comments:

Comments:

INITIAL SITE SKETCH

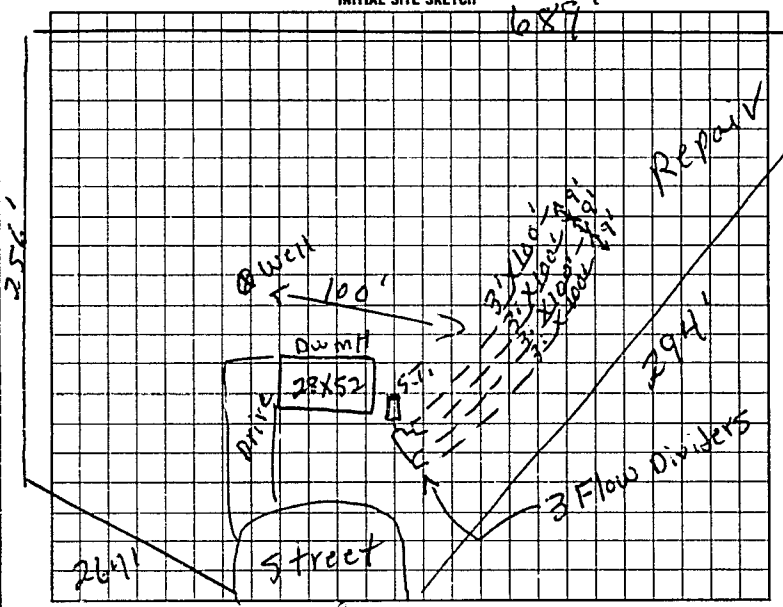

AS BUILT SKETCH

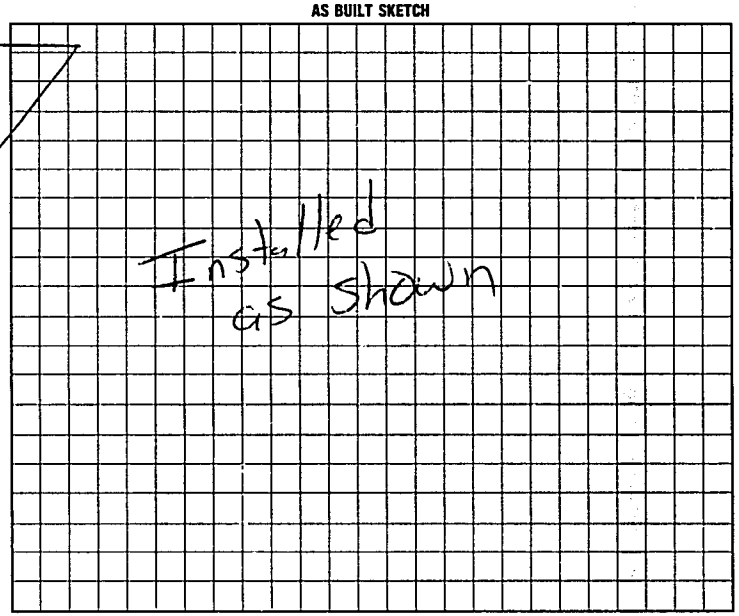

I understand that this permit can be suspended or revoked if any false information is supplied toward securing the permit/any unauthorized changes are made to the site/any unauthorized changes are made in the installation of the system.

Signed: X David Shirkhalth

Improvement Permit by: P.C. Moore date 11-6-96

Authorization to Construct by: P.C. Moore date 11-6-96

Installed by: Rowan Sept.c

Certificate of Completion by: date

Operation Permit by: Mark C. Ott RS date 12-3-96

HEALTH DEPT. COPY: WHITE INSPECTION COPY (FINAL): GREEN OWNER COPY (FINAL): YELLOW INSPECTION COPY (INITIAL): PINK OWNER COPY (INITIAL): GOLD

to commence Authorization to Const. Expires 60 mos. From issue

6210000