60799

IREDELL COUNTY HEALTH DEPARTMENT

STATESVILLE 704-878-5305 MOORESVILLE 704-664-5281

IMPROVEMENT PERMIT / CERTIFICATE OF COMPLETION / OPERATION PERMIT / EXISTING SYSTEM INSPECTION

PROPERTY DESCRIPTION NO. 23437 DATE 4-20-96 TAX MAP NO. 8A A 75 Watershed: ☐ Yes ☑ No

OWNER OR CONTRACTOR Clyde Hall Enterprises PHONE: Business 664 6400 Home

ADDRESS PO Box 1556 mooresville

LOCATION Old mtn Rd west TR Lindsey Fm Rd 1/2 mi Rt

SUBDIVISION LINDSEY FARM Ac BLOCK / SECTION I LOT 13 LOT AREA 0.717 ACRE SITE CLASS RS DESIGN FLOW 360 L.T.A.R. 0.30 GPD/FT²

Septic Tank: 1000 Gallons; STB 825 Date 3-2-96
Pump Tank: ____ Gallons; PT ____ Date ____
Pump Make: ____ Model ____ Serial No. ____
Nitrification Field: No Fields 1 Square Feet 1200 Linear Feet 400
No Lines 4 Trench Width 36" Max Trench Bottom Depth 18-36" Gravel Depth 12"

☑ New System ☐ Repair System Type: I. II. III. IV. V. VI
System Description: CONVENTIONAL GRAVITY
Repair System Description: CONV. GRAVITY
Maintenance Agreement Required: ☐ Yes ☑ No


☐ House/Mod. Home No. Bedrooms 3
☑ Mobile Home No. Bathrooms 2
☐ Business No. Employees ____
☐ Other ____
☐ Slab ☑ Crawl Space ☐ Basement w/plumbing ☐ Basement wo/plumbing

Water Supply: ☑ Individual ☐ Community ☐ Public WELL

Comments: ① KEEP SYSTEM MINIMUM 100' FROM WELL
② USE THREE FLOW DIVIDER TEES TO ACHIEVE EQUAL DISTRIBUTION INTO EACH OF 4 (FOUR) 100' LINES

Comments:

INITIAL SITE SKETCH

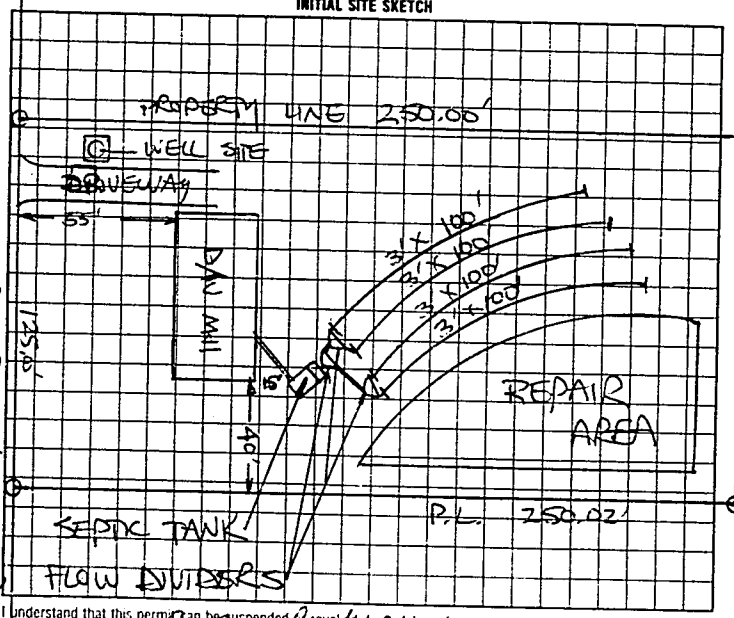

AS BUILT SKETCH

Same as initial Sketch

LINDSEY FARM ROAD (SR 1534)

I understand that this permit can be suspended or revoked if any false information is supplied toward securing the permit/any unauthorized changes are made to the site/any unauthorized changes are made in the installation of the system

Signed: David B. Stahlecker

Improvement Permit by: R. C. Moore date 4-20-96 Installed by: Rowan S.T. Co.

Authorization to Construct

Existing System Inspection by: R. C. Moore date 4-20-96 Certificate of Completion by: ____ date ____

Operation Permit by: R. C. Moore date 5-16-96

EXPIRES 60 MOS FROM ISSUE

HEALTH DEPT. COPY, WHITE INSPECTION COPY (FINAL): GREEN OWNER COPY (FINAL): YELLOW INSPECTION COPY (INITIAL): PINK OWNER COPY (INITIAL): GOLD