60614

IREDELL COUNTY HEALTH DEPARTMENT

STATESVILLE 704-878-5305 MOORESVILLE 704-664-5281

IMPROVEMENT PERMIT / CERTIFICATE OF COMPLETION / OPERATION PERMIT / EXISTING SYSTEM INSPECTION

PROPERTY DESCRIPTION NO. 23436 DATE 4-20-96 TAX MAP NO. 8UA75 Watershed: ☐ Yes ☐ No

OWNER OR CONTRACTOR Clyde Hall Enterprises PHONE: Business _____ Home 664 6400

ADDRESS PO Box 1556 Mooresville

LOCATION Old Wtrs Rd West TR Lindsey Farm Rd 1/2mi on Rt

SUBDIVISION LINDSEY FARM ACRES BLOCK / SECTION I LOT 14 LOT AREA 0.774 ACRE SITE CLASS PS DESIGN FLOW 360 L.T.A.R. 0.30 GPD/ft²

Septic Tank: 1000 Gallons; STB 825 Date 3-1-96

Pump Tank: _____ Gallons; PT _____ Date _____

Pump Make: _____ Model _____ Serial No. _____

Nitrification Field: No Fields 1 Square Feet 1200 Linear Feet 400

No Lines 4 Trench Width 36" Max Trench Bottom Depth 18-36" Gravel Depth 12"

☑ New System ☐ Repair System Type: I. II. III. IV. V. VI

System Description: CONVENTIONAL GRAVITY

Repair System Description: _____

Maintenance Agreement Required: ☐ Yes ☐ No

☐ House/Mod. Home No. Bedrooms 3

☑ Mobile Home No. Bathrooms 2

☐ Business No. Employees ____

☐ Other _____


☐ Slab ☑ Crawl Space ☐ Basement w/plumbing ☐ Basement wo/plumbing

Water Supply: ☑ Individual ☐ Community ☐ Public WELL

Comments: ① KEEP SYSTEM MINIMUM 100' FROM WELL. ② USE THREE FLOW DIVIDER TEES TO ACHIEVE EQUAL DISPERSION INTO EACH OF FOUR 100' LINES

Comments:

INITIAL SITE SKETCH

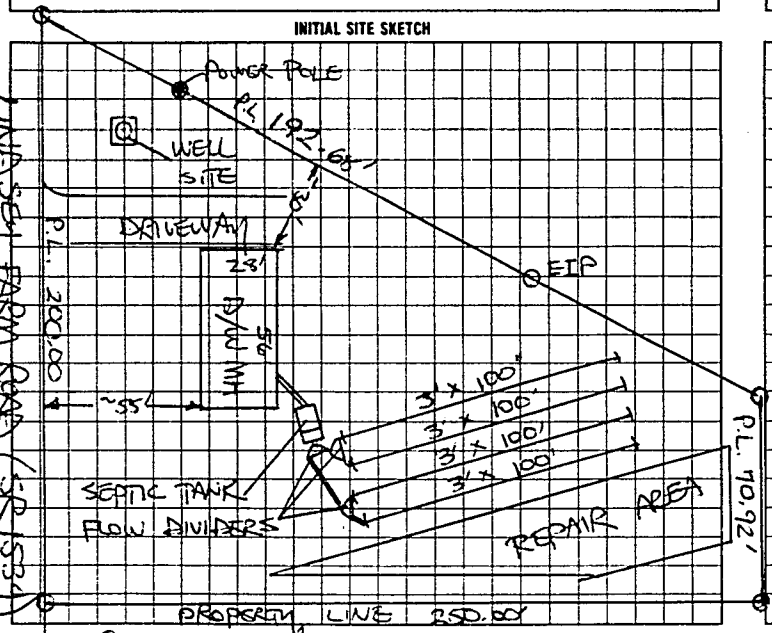

AS BUILT SKETCH

Same as initial Sketch

I understand that this permit can be suspended or revoked if any false information is supplied toward securing the permit/any unauthorized changes are made to the site/any unauthorized changes are made in the installation of the system.

Signed: David B Strickland Installed by: Rowan S.T. Co.

Improvement Permit by: L.C. Moore date 4-20-96 Certificate of Completion by: _____ date _____

Existing System Inspection by: L.C. Moore date 4-20-96 Operation Permit by: L.C. Moore date 5-16-96

+0 C 4 HEALTH DEPT. COPY. WHITE INSPECTION COPY (FINAL) GREEN OWNER COPY (FINAL) YELLOW INSPECTION COPY (INITIAL) PINK OWNER COPY (INITIAL) GOLD

Authorization to Count Expires 60 mos from issue

ISSUED