IREDELL COUNTY HEALTH DEPARTMENT

Statesville Office (704) 878-5305 Mooresville Office (704) 660-3625 PERMIT # 210236

IMPROVEMENT PERMIT / AUTHORIZATION TO CONSTRUCT / OPERATION PERMIT / EXISTING SYSTEM

PIN # 3796526343

APPLICANT: Chris Moose APPLICANT ADDRESS: 236 Lindsey Farm Rd.

SITE ADDRESS: 234 Lindsey Farm Rd PHONE: 704-902-6611 ALT. PHONE: N/A

SITE DIRECTIONS: Hwy 64 W TL Lackey Farm Rd TL Myracle Farm Rd TR Lindsey Farm Rd. Property on Right


SUBDIVISION: N/A SECTION: N/A LOT # N/A LOT AREA: 0.1533 acres DESIGN FLOW: 360gpd L.T.A.R.: 0.0275

Septic Tank	1000 (gal)	STB	160-1000	Date	7-13-15	☑ New System	☐ Repair	☐ Expansion	System Type: I II (III) IV V VI	☑ Residence	No. Bedrooms 3
Pump Tank	(gal)	PT		Date		System Description:	25% Reduction			☐ Business	No. Persons 6
Pump Make		Model		Serial #		Repair System Description:	50% Reduction			☐ Other	No. Employees
# Nitrification Fields	1	# Lines	5	Linear Ft:	328	Maintenance Agreement Required:	☐ YES	☑ NO		☐ Slab	☑ Crawl Space
Trench Width	36"	Max. Trench Bottom Depth	30"	Gravel Depth	N/A		☑ GRAVITY	☐ PRESSURE		☐ Basement w/plumbing	☐ Basement w/o plumbing


Water Supply: ☑ Private ☐ Public ☐ Community

Comments / Conditions: IMPROVEMENTS ONLY! Subdivided & record proposed new property prior to issuance of CA! Install a 25% Reduction system on contours with serial distribution.

INITIAL SITE SKETCH

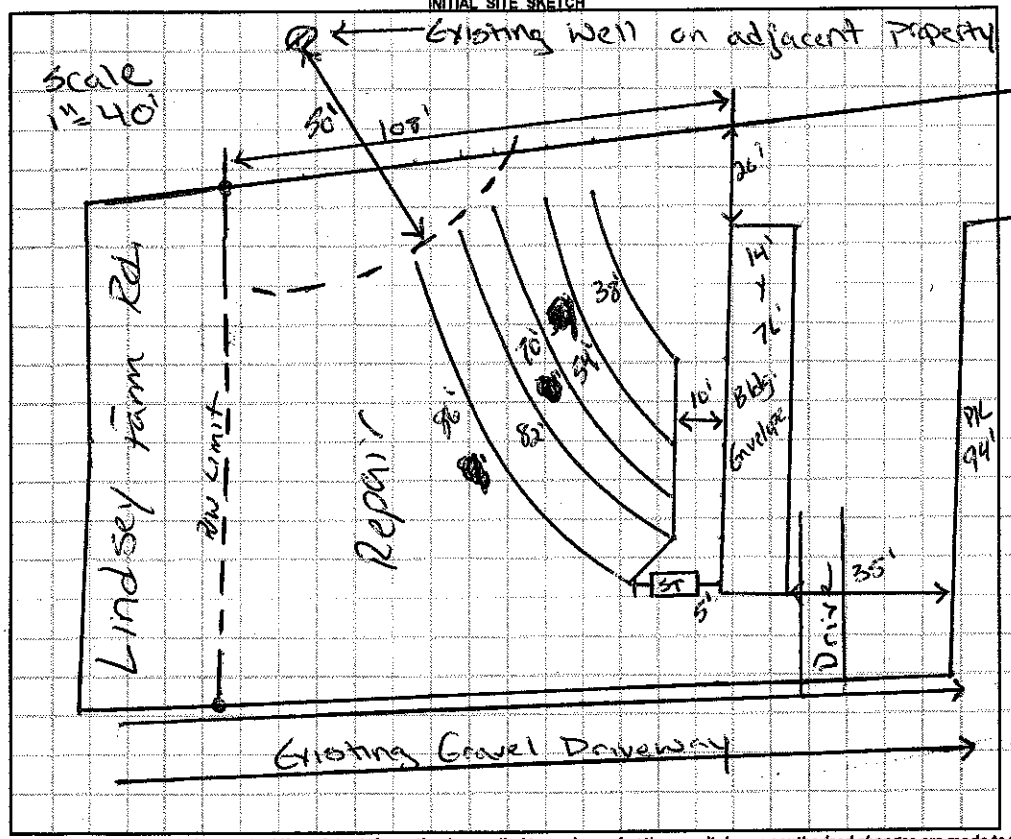

AS BUILT SKETCH

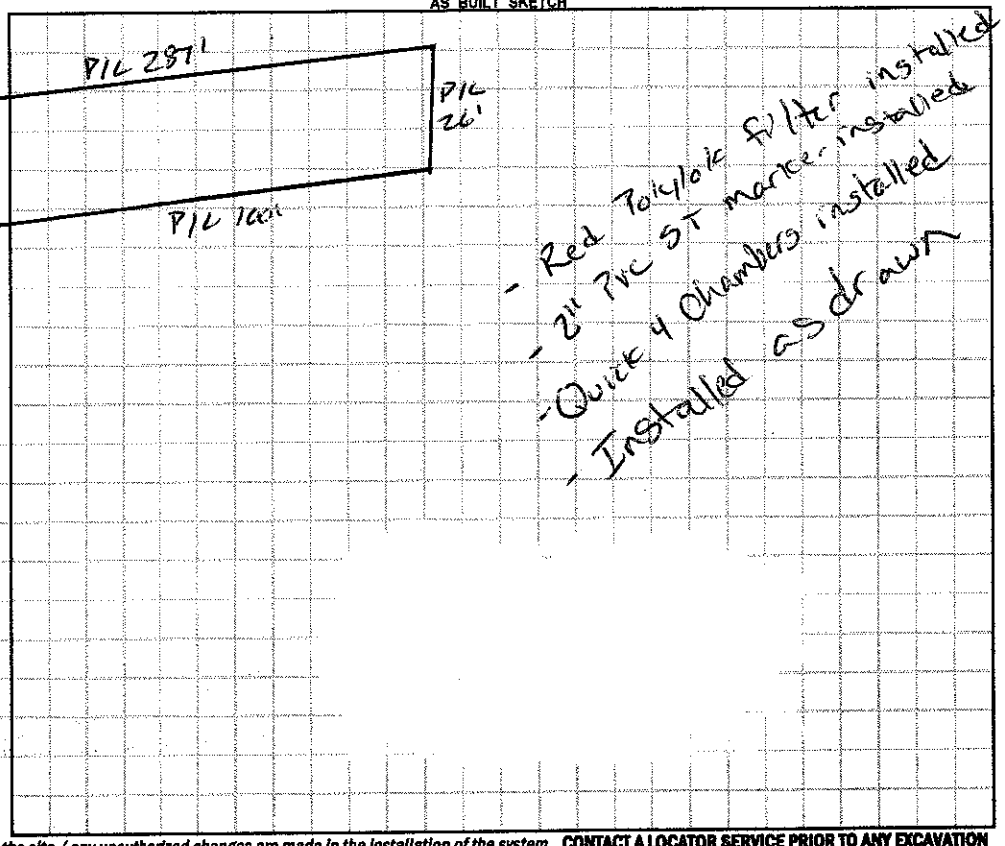

Permit can be suspended or revoked if any false information is supplied toward securing the permit / any unauthorized changes are made to the site / any unauthorized changes are made in the installation of the system. **CONTACT A LOCATOR SERVICE PRIOR TO ANY EXCAVATION**

☐ **IMPROVEMENT PERMIT** *with plot valid without expiration.* ☑ **IMPROVEMENT PERMIT** *with site plan valid for 60 mos.* ☑ **AUTHORIZATION TO CONSTRUCT** *valid for period equal to IMPROVEMENT PERMIT--not to exceed 60 mo.*

Owner / Applicant Signature: [signature] Date: 7-7-15 Installed by: K & M Grading

IMPROVEMENT PERMIT by: Justin Henderson Date: 6-2-15 OPERATION PERMIT by: Justin Henderson Date: 9-11-15

AUTHORIZATION TO CONSTRUCT by: Justin Henderson Date: 7-7-15 Existing System Inspected by: Date:

Health Dept. Copy - WHITE Applicant (Final Approval) - YELLOW Applicant (Conditional Approval) - PINK